

0.12 S
1.47 W

New Location
 Drill Deeper
 Abandonment

Coal & surface owned by T.G. Baker, whose post-office address is Route 2, Salem, W. Va.

Company L.G. PIGGOTT
 Address West Union, West Va.
 Farm Baker Heirs
 Tract _____ Acres 1/2 of 55 Lease No. _____
 Well (Farm) No. _____ Serial No. _____
 Elevation (Spirit Level) 1167'
 Quadrangle Centerpoint
 County Doddridge District Grant
 Engineer W. H. H. H.
 Engineer's Registration No. 1227
 File No. _____ Drawing No. _____
 Date June, 1949 Scale 1" = 660' or 40 poles = 1 inch.

STATE OF WEST VIRGINIA
 DEPARTMENT OF MINES
 OIL AND GAS DIVISION
 CHARLESTON

WELL LOCATION MAP
 FILE NO. DOD-762-A

+ Denotes location of well on United States Topographic Maps, scale 1 to 62,500, latitude and longitude lines being represented by border lines as shown.

- Denotes one inch spaces on border line of original tracing.

WEST VIRGINIA DEPARTMENT OF MINES
OIL AND GAS DIVISION

670

WELL RECORD

Permit No. 762-A


Oil or Gas Well Gas
(Kind)

Company Israels Fork Gas Company, L. G. Pigott, Agent
 Address West Union, W. Va.
 Farm Baker Acres 27 1/2
 Location (waters) Big Flint
 Well No. H. N. G. C. 2402 Elev. 1167
 District Grant County Doddridge
 The surface of tract is owned in fee by Baker Heirs
 Address _____
 Mineral rights are owned by _____
 Address _____
 Drilling commenced November 1911
 Drilling completed April 1912
 Date shot _____ Depth of shot _____
 Open Flow /10ths Water in _____ Inch
 /10ths Merc. in _____ Inch
 Volume _____ Cu. Ft.
 Rock Pressure _____ lbs. _____ hrs.
 Oil _____ bbls., 1st 24 hrs.
 Fresh water _____ feet _____ feet
 Salt water _____ feet _____ feet

Casing and Tubing	Used in Drilling	Left in Well	Packers
Size			Kind of Packer
16			
13			
10	400	390	Size of
8 1/4	1439	456	983
6 5/8	1977	1977	Depth set
5 3/16			
3			Perf. top
2			Perf. bottom
Liners Used			Perf. top
			Perf. bottom

CASING CEMENTED _____ SIZE _____ No. FT. _____ Date _____
 COAL WAS ENCOUNTERED AT 658 FEET _____ INCHES
 _____ FEET _____ INCHES _____ FEET _____ INCHES
 _____ FEET _____ INCHES _____ FEET _____ INCHES

Formation	Color	Hard or Soft	Top	Bottom	Oil Gas or Water	Depth Found	Remarks
Pittsburgh Coal			658	662			
Big Dunkard			1080	1205			
Salt sand			1411	1646			
Maxon			1834	1900			
Big Injun			1989	2175	Gas	2171	
Total Depth			2226				

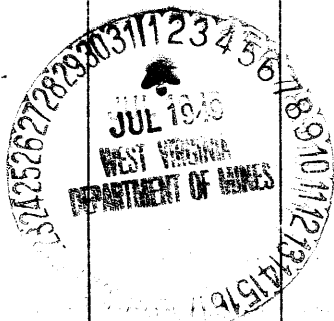

(Over)

NOV - 4 1912

Formation	Color	Hard or Soft	Top	Bottom	Oil, Gas or Water	Depth Found	Remarks

Date June 29, 1949

APPROVED Israel Park Gas Co., Owner

By L. G. Pizott, agent
(Title)

Grant District, Hedderidge County, W. Va.
 By Inroads Rock Gas Co., L. G. Pigott, Agent, West Union, W. Va.
 (Hope Natural Gas Co. well).
 Abandoned under permit No.-A7
 On 27 1/2 acres, on Big Flint Creek.
 Elevation, 1167' L.
 Surface owned by Baker Heirs.
 Drilling commenced Nov. 1911; completed April 1912.
 10" casing, 400' 390' left in; 8", 1439' (989' left in); 6", 1977'.
 Coal was encountered at 658-662'.
 Gas well. Record to Dept. of Mines dated June 29, 1949.
 Record to NCT from Mrs. Griffith Nov. 4, 1949. Old file no. 670.

	Top.	Bottom.
Pittsburgh Coal	658	662
Big Bankard Sand	1080	1205
Salt Sand	1411	1646
Marion Sand	1874	1900
Big Injun Sand (gas, 2171')	1989	2175
Total depth		2226