

Surface owned by Martha A. Zeigler Hrs.
 Address: Mrs. Gertrude Underwood, R.F.D. No. 2, West Union, W. Va.
 No coal ever sold under this tract of land, if any, it belongs to the owners of the surface.

New Location
 Drill Deeper
 Abandonment On 800' Map N37, Sqs. S6 W6-7.

Company Randall-Zogg Supply Co.
 Address Owensboro, Ky.
 Farm Silas Ash
 Tract _____ Acres 291 1/2 Lease No. _____
 Well (Farm) Nos. 2, 8, & 10 Serial No. _____
 Elevation (Spirit Level) see wells above for Elev
 Quadrangle Centerpoint
 County Doddridge District Grant
 Engineer A. L. Headley
 Engineer's Registration No. 2021
 File No. _____ Drawing No. _____
 Date June 2nd, 1949 Scale 1" = 800 Feet.

STATE OF WEST VIRGINIA
 DEPARTMENT OF MINES
 OIL AND GAS DIVISION
 CHARLESTON

WELL LOCATION MAP
 FILE NO. DOD-765-A-#2
DOD-766-A-#8
DOD-767-A-#10

+ Denotes location of well on United States Topographic Maps, scale 1 to 62,500, latitude and longitude lines being represented by border lines as shown.

- Denotes one inch spaces on border line of original tracing.



STATE OF WEST VIRGINIA
DEPARTMENT OF MINES
OIL AND GAS DIVISION

646

WELL RECORD

Permit No. AP 767 A

Oil or Gas Well **OIL**
(KIND)


Company RANDALL-ZOGG SUPPLY COMPANY
Address BOX 526, CHARLESTON, 22 W. VA.
Farm Silas Ash Acres 201 1/2
Location (waters) Little Flint Creek
Well No. Ten (10) Elev. 1022.15
District Grant County Doddridge
The surface of tract is owned in fee by Martha A. Zaigler
Hairs, Address West Union, W. Va.
Mineral rights are owned by Martha A. Zaigler Hairs,
e/o Mrs. Gertrude Underwood, R.D. #2, West Union,
W. Va.
Drilling commenced _____
Drilling completed _____
Date Shot SEE BELOW From _____ To _____
With _____
Open Flow _____ /10ths Water in _____ Inch
_____ /10ths Merc. in _____ Inch
Volume _____ Cu. Ft.
Rock Pressure _____ lbs. _____ hrs.
Oil _____ bbls., 1st 24 hrs.
Fresh water _____ feet _____ feet
Salt water _____ feet _____ feet

Casing and Tubing	Used in Drilling	Left in Well	Packers
Size			
16			Kind of Packer
13			
10			Size of
8 1/2	1311'		
6 1/2	2070'	2070'	Depth set
5 3/16	1120'	1120'	
3			Perf. top
2	2189'	2189'	Perf. bottom
Liners Used			Perf. top
			Perf. bottom

CASING CEMENTED _____ SIZE _____ No. Ft. _____ Dat _____

COAL WAS ENCOUNTERED AT 720 FEET _____ INCHES
_____ FEET _____ INCHES FEET _____ INCHES
_____ FEET _____ INCHES FEET _____ INCHES

Formation	Color	Hard or Soft	Top	Bottom	Oil, Gas or Water	Depth Found	Remarks
Pittsburgh Coal			720'				
Big Injun Sand			2085'		Oil & Gas	2165'	
Total Depth				2189'			
SHOT RECORD							
	<u>DATE OF SHOT</u>			<u>NO. OF QTS.</u>		<u>TOP OF SHOT</u>	
	2-18-97			16		2165	
	6-27-01			20		No Record	

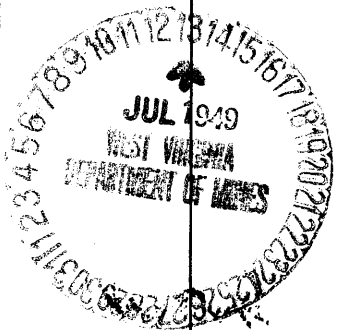

(Over)

SEP 27 1949

Grant District, Doddridge County, W. Va.
 By Randall-Zegg Supply Co., Box 526, Charleston, 22, W. Va.
 Abandoned under permit Dod-.....-A?
 On 291-1/8 acres, on Little Flint Creek.
 Elevation, 1028.15' L.
 Surface and minerals owned by Martha A. Zeigler Heirs, Mrs. Gertrude
 Underwood, R. D. No. 2, West Union, W. Va.
 Shot Feb. 18, 1897, with 16 qts., top of shot, 2163'; June 27, 1901,
 with 20 qts.,
 8 1/2" casing, 1311' (pulled); 6 1/2", 2070'; 5 1/2", 1120'; 2" tubing, 2189'.
 Coal was encountered at 720'.
 Oil well. Record to Dept. of Mines dated July 11, 1949.
 Record to RCF from Mrs. Griffith September 27, 1949. Old File No. 646.

	Top.	Bottom.
Pittsburgh Coal	720 -	...
Big Injun Sand (oil and gas, 2165')	2083 -
Total depth		2189