

#1	3.91 S
	4.46 W
#2	3.80 S
	4.41 W

Surface owned by Wilmer D. & Katherine J. Knight.
 Address: Mr. Wilmer D. Knight, Washington, Wood Co. W. Va.
 Coal never sold under this tract of land, if any, it belongs to the owners of the surface.

- New Location...
 Drill Deeper...
 Abandonment...

On 800' Map N37. Sqs. 5 6 W 7-8.

Company Randall-Zogg Supply Co.
 Address Owensboro, Ky.
 Farm Henry Knight
 Tract _____ Acres 110 Lease No. WC
 Well (Farm) Nos. 1 & 2 Serial No. _____
 Elevation (Spirit Level) See wells above for Elev
 Quadrangle Centerpoint
 County Doddridge District Grant
 Engineer A. L. Headley
 Engineer's Registration No. 2021
 File No. _____ Drawing No. _____
 Date June 1st, 1949. Scale 1" = 400 Feet

STATE OF WEST VIRGINIA
 DEPARTMENT OF MINES
 OIL AND GAS DIVISION
 CHARLESTON

WELL LOCATION MAP

FILE NO. DOD - 768-A - #1
DOD - 769-A - #2

+ Denotes location of well on United States Topographic Maps, scale 1 to 62,500, latitude and longitude lines being represented by border lines as shown.

- Denotes one inch spaces on border line of original tracing.



STATE OF WEST VIRGINIA
DEPARTMENT OF MINES
OIL AND GAS DIVISION

656

WELL RECORD

Permit No. 765-A

Oil or Gas Well OIL
(KIND)

Company RANDALL-ZOGG SUPPLY COMPANY
Address BOX 526, CHARLESTON, 22 W. VA.
Farm Henry Knight Acres 110
Location (waters) _____
Well No. One (1) Elev. 875.02
District Grant County Doddridge

The surface of tract is owned in fee by Wilmer D. & Katherine J. Knight Address Washington, W. Va.
Mineral rights are owned by Wilmer D. & Katherine J. Knight Address Washington, W. Va.

Drilling commenced _____
Drilling completed _____
Date Shot SEE BELOW From _____ To _____
With _____


Open Flow /10ths Water in _____ Inch
/10ths Merc. in _____ Inch
Volume _____ Cu. Ft.
Rock Pressure _____ lbs. _____ hrs.
Oil _____ bbls., 1st 24 hrs.
Fresh water _____ feet _____ feet
Salt water _____ feet _____ feet

Casing and Tubing	Used in Drilling	Left in Well	Packers
Size			
16			Kind of Packer
13			
10	<u>558'</u>		Size of
8 1/4	<u>1100'</u>		
6 3/4	<u>1878'</u>	<u>1878'</u>	Depth set
5 3/16	<u>1040'</u>	<u>1040'</u>	
3			Perf. top
2	<u>2015'</u>	<u>2015'</u>	Perf. bottom
Liners Used			Perf. top
			Perf. bottom

CASING CEMENTED _____ SIZE _____ No. Ft. _____ Dat _____

COAL WAS ENCOUNTERED AT 556 FEET _____ INCHES
_____ FEET _____ INCHES FEET _____ INCHES
_____ FEET _____ INCHES FEET _____ INCHES

Formation	Color	Hard or Soft	Top	Bottom	Oil, Gas or Water	Depth Found	Remarks
Pittsburgh Coal			556'				
Dunkard Sand			1150'				
Big Injun Sand			1902'		Oil & Gas	1977'	
Total Depth				2015'	Oil	1990'	
SHOT RECORD							
	DATE SHD		QTS.	TOP OF SHD			
	12-16-98		16	1988'			
	8-7-99		20	1988'			
	5-20-05		30	1987'			
	10-11-10		60	1985'			

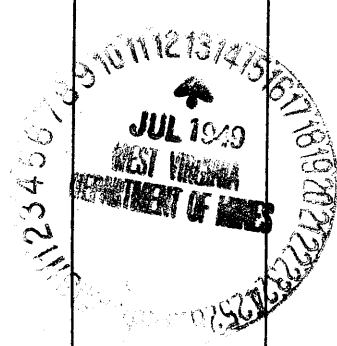

768A

HENRY KNIGHT NO. 1 WELL.

Grant District, Doddridge County, W. Va.
By Randall-Zegg Supply Co., Box 526, Charleston, 22, W. Va.
Abandoned under permit No.-A7
On 110 acres.

Elevation, 875.02' L.

Surface and minerals owned by Wilmer D. and Katherine J. Knight,
Washington, W. Va.

Shot Dec. 16, 1896, with 16 qts., top of shot, 1988'; Sept. 7, 1899,
with 20 qts., top of shot, 1988'; May 20, 1905, with 30 qts.,
top of shot, 1987'; Oct. 11, 1910, with 60 qts., top of shot, 1993'.
10" casing, 358' (pulled); 8", 1100' (pulled); 6", 1878'; 5", 1040';
2" tubing, 2013'.

Coal was encountered at 556'.

Oil well. Record to Dept. of Mines dated June 9, 1949.

Record to ROT from Mrs. Griffith September 27, 1949. Old File No. 655.

	Top.	Bottom.
Pittsburgh Coal	556	- ...
Dunkard Sand	1150	-
Big Injun Sand (oil and gas, 1977') (oil, 1990')	1902	-
Total depth		2013

#90 in DH Co Rep