

New Location   
 Drill Deeper   
 Abandonment

Company ROHE CASING CO.  
 Address Hamlin, West Va.  
 Farm M. T. Williams  
 Tract \_\_\_\_\_ Acres 350 Lease No. \_\_\_\_\_  
 Well (Farm) No. One Serial No. \_\_\_\_\_  
 Elevation (Spirit Level) 1015  
 Quadrangle Centerpoint  
 County Doddridge District Greenbrier  
 Engineer Westboer  
 Engineer's Registration No. 1227  
 File No. \_\_\_\_\_ Drawing No. \_\_\_\_\_  
 Date June, 1949 Scale 1" = 800'

STATE OF WEST VIRGINIA  
 DEPARTMENT OF MINES  
 OIL AND GAS DIVISION  
 CHARLESTON

**WELL LOCATION MAP**  
 FILE NO. DOD-773-A

+ Denotes location of well on United States Topographic Maps, scale 1 to 62,500, latitude and longitude lines being represented by border lines as shown.

- Denotes one inch spaces on border line of original tracing.



STATE OF WEST VIRGINIA  
DEPARTMENT OF MINES  
OIL AND GAS DIVISION

667

WELL RECORD

Permit No. 773-A

Oil or Gas Well  (KIND)


Company South Penn Natural Gas Co.  
Address Parkersburg, W. Va.  
Farm M. P. Williams Acres 50  
Location (waters) \_\_\_\_\_  
Well No. 1 Elev. 1015  
District Greenbrier County Dodridge  
The surface of tract is owned in fee by \_\_\_\_\_  
Address \_\_\_\_\_  
Mineral rights are owned by \_\_\_\_\_  
Address \_\_\_\_\_  
Drilling commenced \_\_\_\_\_  
Drilling completed April 5, 1902  
Date Shot \_\_\_\_\_ From \_\_\_\_\_ To \_\_\_\_\_  
With \_\_\_\_\_  
Open Flow \_\_\_\_\_ /10ths Water in \_\_\_\_\_ Inch  
\_\_\_\_\_ /10ths Merc. in \_\_\_\_\_ Inch  
Volume \_\_\_\_\_ Cu. Ft.  
Rock Pressure \_\_\_\_\_ lbs. \_\_\_\_\_ hrs.  
Oil \_\_\_\_\_ bbls., 1st 24 hrs.  
Fresh water \_\_\_\_\_ feet \_\_\_\_\_ feet  
Salt water \_\_\_\_\_ feet \_\_\_\_\_ feet

Casing and Tubing	Used in Drilling	Left in Well	Packers
Size			
16			Kind of Packer
13			
10		436	Size of
8 1/4		1276	
6 1/2		2178	Depth set
5 3/16			
3			Perf. top
2			Perf. bottom
Liners Used			Perf. top
			Perf. bottom

CASING CEMENTED \_\_\_\_\_ SIZE \_\_\_\_\_ No. Ft. \_\_\_\_\_ Dat \_\_\_\_\_


COAL WAS ENCOUNTERED AT \_\_\_\_\_ FEET \_\_\_\_\_ INCHES  
\_\_\_\_\_ FEET \_\_\_\_\_ INCHES FEET \_\_\_\_\_ INCHES  
\_\_\_\_\_ FEET \_\_\_\_\_ INCHES FEET \_\_\_\_\_ INCHES

Formation	Color	Hard or Soft	Top	Bottom	Oil, Gas or Water	Depth Found	Remarks	
Pgh Coal			945	952				
Hunkard Sand			1455	1470				
Salt Sand			1795	1850				
Big Lime			2020	2080				
Big Injun			2080	2160				
Fifty Foot			2590	2630				
Stray Sand			2785	2792				
Gordon Sand			2816	2826				
Gas			2890	2818				
Oil			2890	2818				
Total Depth				2836				
Initial Production								
Gordon Sand			- No data					

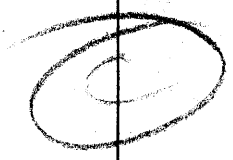

TORPEDO RECORD  
1902 -- 20 qts. -- Top 2818  
1903 -- 30 " -- " 2836  
1904 -- 20 " -- " 2818  
1909 -- 40 " -- " 2818

Remarks: Nov. 13, 1907  
203' - 5" X 5 1/2" F. J. Casing.  
Hung on Cave Packer - Top  
2602' - Bottom Jt. Perf.

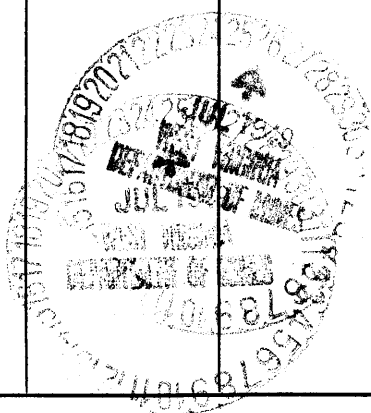

Greenbrier District, Doddridge County, W. Va.  
 By South Penn Natural Gas Co., Parkersburg, W. Va.  
 Abandoned under permit Dod-----A?  
 On 350 acres.

Elevation,.....' L.

Drilling completed April 5, 1902.

10" casing, 436'; 8 1/4", 1276'; 6", 2178'; all left in.

Shot in 1902 with 20 qts., top, 2818'; in 1903, with 30 qts., top, 2836';  
 in 1904, with 20 qts., top, 2818'; in 1909, with 40 qts., top, 2818'.

Remarks: Nov. 13, 1907. 203' - 5x5 1/2" F. J. casing, hung on cave packer -  
 top, 2602'; bottom joint perforated.

Oil well. Record to Dept. of Mines stamped July 26, 1949.

Record to RCT from Mrs. Griffith September 27, 1949. Old File No. 667.

	Top.	Bottom.
Pittsburgh Coal	945	952
Dunkard Sand	1455	1470
Salt Sand	1795	1850
Big Lime	2020	2080
Big Injun Sand	2080	2160
Fifty-foot Sand	2590	2630
Stray Sand	2785	2792
Gordon Sand (gas, 2090-2818') (oil, 2090- 2818')	2816	2826
Total depth		2836

# 284 DH C Rep