

1.16 S
0.00 W

New Location
 Drill Deeper
 Abandonment

Coal & surface - Walter Burbridge, New Milton West Va.

Company **P. AND M. OIL CO.**
 Address **West Union, W. Va.**
 Farm **Flem Burbridge**
 Tract _____ Acres **43** Lease No. _____
 Well (Farm) No. **One** Serial No. _____
 Elevation (Spirit Level) **1060'**
 Quadrangle **Vadis**
 County **Doddridge** District **New Milton**
 Engineer *W. S. [Signature]*
 Engineer's Registration No. **1227**
 File No. _____ Drawing No. _____
 Date **June, 1949** Scale **1" = 500'**

STATE OF WEST VIRGINIA
 DEPARTMENT OF MINES
 OIL AND GAS DIVISION
 CHARLESTON

WELL LOCATION MAP
 FILE NO. **DOD-787-A**

+ Denotes location of well on United States Topographic Maps, scale 1 to 62,500, latitude and longitude lines being represented by border lines as shown.
 - Denotes one inch spaces on border line of original tracing.



647

STATE OF WEST VIRGINIA
DEPARTMENT OF MINES
OIL AND GAS DIVISION

WELL RECORD

AD 757-A
Permit No. 757-A


Oil or Gas Well oil
(KIND)

Company P. & M. Oil Company
 Address West Union, W. Va.
 Farm Flem Burbridge Acres 45
 Location (waters) Red Lick Run
 Well No. 1 Elev. 1060
 District New Milton County Doddridge
 The surface of tract is owned in fee by Flem Burbridge
 Address New Milton, W. Va.
 Mineral rights are owned by "
 Address _____
 Drilling commenced March 12, 1925
 Drilling completed _____
 Date Shot _____ From _____ To _____
 With _____
 Open Flow /10ths Water in _____ Inch
 /10ths Merc. in _____ Inch
 Volume _____ Cu. Ft.
 Rock Pressure _____ lbs. _____ hrs.
 Oil _____ bbls., 1st 24 hrs.
 Fresh water _____ feet _____ feet
 Salt water _____ feet _____ feet

Casing and Tubing	Used in Drilling	Left in Well	Packers
Size			
16			Kind of Packer
13			
10	340	0	Size of
8 1/2	1285	0	
6 1/2	2120	2120	Depth set
5 3/16			
3			Perf. top
2			Perf. bottom
Liners Used			Perf. top
			Perf. bottom

CASING CEMENTED _____ SIZE _____ No. Ft. _____ Date _____
 COAL WAS ENCOUNTERED AT 765 FEET _____ INCHES
 _____ FEET _____ INCHES FEET _____ INCHES
 _____ FEET _____ INCHES FEET _____ INCHES

Formation	Color	Hard or Soft	Top	Bottom	Oil, Gas or Water	Depth Found	Remarks
Pittsburgh coal			765	767			
Little dunkard			1180	1200			
Big dunkard			1285	1355			
Gas sand			1405	1445			
1st. salt			1510	1615			
2nd. "			1640	1714			
3rd. "			1745	1765			
Sand			1785	1875			
Maxon			1967	2032			
Little Lime			2077	2095			
Red rock			2075	2100			
Pencil cave			2105	2115			
Big Lime			2115	2162			
Big Injun			2162	2237			
Oil (show)			2190	2195			
Total Depth			2254				

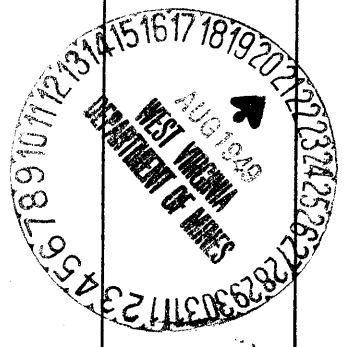

Formation	Color	Hard or Soft	Top	Bottom	Oil, Gas or Water	Depth Found	Remarks

Date Aug. 19, 1949

APPROVED H. M. Oil Co, Owner

By L. S. Rydell, Asst
(Title)