


Latitude 39°30'

Longitude 80°20'

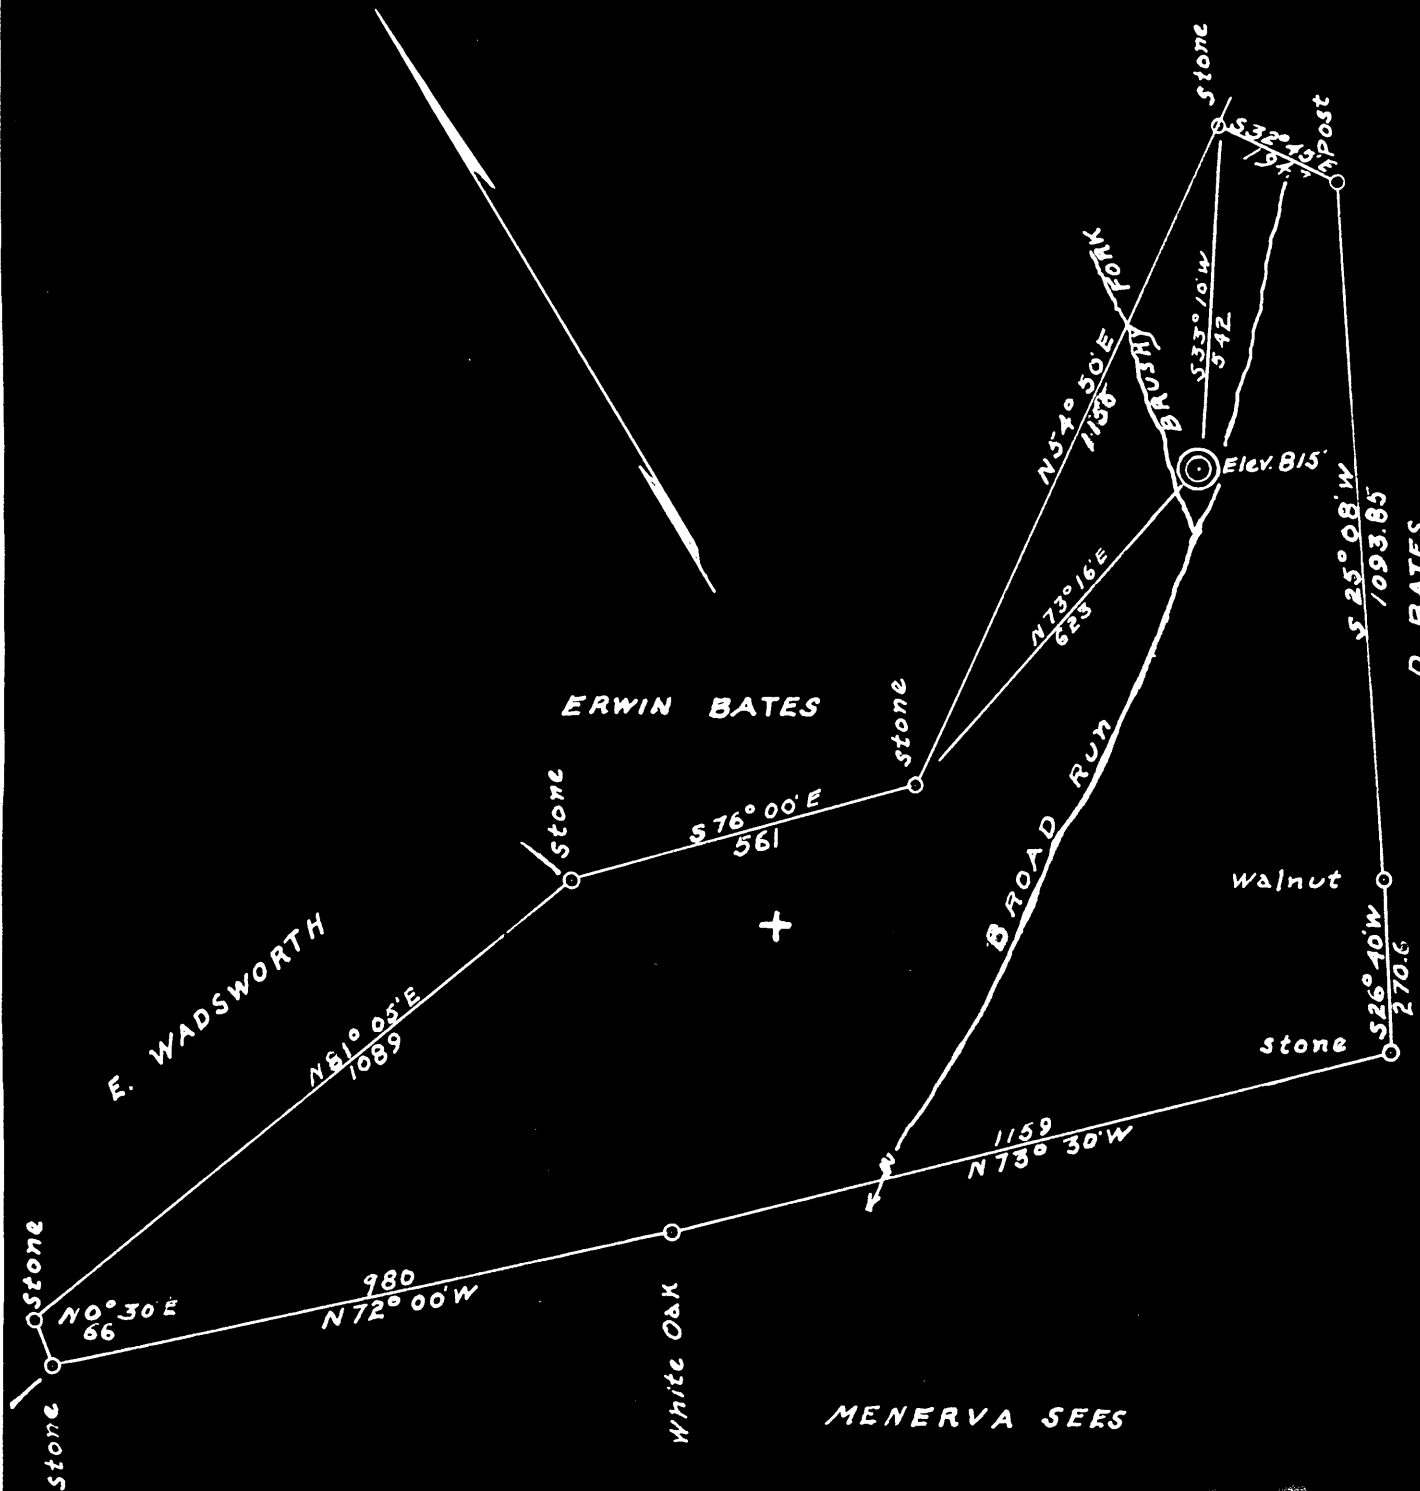

MENERVA SEES

5.62 S
3.50 W

Abandonment

Company L.B. Coffman Oil & Gas Co.
 Address Salem, W.Va. R.F.D. No. 2
 Farm Malissa Scott
 Tract 1 Acres 34.4 Lease No. _____
 Well (Farm) No. 1 Serial No. MC
 Elevation (Spirit Level) 815
 Quadrangle Center Point
 County Doddridge District McClellan
 Engineer George L. McIntire
 Engineer's Registration No. 1187
 File No. _____ Drawing No. _____
 Date 8/18/49 Scale 1" = 300'

STATE OF WEST VIRGINIA
 DEPARTMENT OF MINES
 OIL AND GAS DIVISION
 CHARLESTON

WELL LOCATION MAP
 FILE NO DOD-794-A

+ Denotes location of well on United States Topographic Maps, scale 1 to 62500, latitude and longitude lines being represented by border lines as shown.

- Denotes one inch spaces on border line of original tracing.



STATE OF WEST VIRGINIA
DEPARTMENT OF MINES
OIL AND GAS DIVISION

693

AB 794 A

WELL RECORD

Permit No. _____ Oil or Gas Well _____ (KIND)

Company L. E. Coffman Oil & Gas Co.
 Address Rte. #2, Salem, W. Va.
 Farm Malissa Scott Acres 34.4
 Location (waters) _____
 Well No. One Elev. 815
 District McClellan County Doddridge
 The surface of tract is owned in fee by _____
 Address _____
 Mineral rights are owned by _____
 Address _____
 Drilling commenced _____
 Drilling completed _____
 Date Shot _____ From _____ To _____
 With _____
 Open Flow _____ /10ths Water in _____ Inch
 _____ /10ths Merc. in _____ Inch
 Volume _____ Cu. Ft.
 Rock Pressure _____ lbs. _____ hrs.
 Oil _____ bbls., 1st 24 hrs.
 Fresh water _____ feet _____ feet
 Salt water _____ feet _____ feet

Casing and Tubing	Used in Drilling	Left in Well	Packers
Size			Kind of Packer
16			
13			
10			Size of
8 1/4			
6 5/8		1909	Depth set
5 3/16		2537	
3			Perf. top
2			Perf. bottom
Liners Used			Perf. top
			Perf. bottom

CASING CEMENTED _____ SIZE _____ No. Ft. _____ Date _____
 COAL WAS ENCOUNTERED AT _____ FEET _____ INCHES
 _____ FEET _____ INCHES FEET _____ INCHES
 _____ FEET _____ INCHES FEET _____ INCHES

Formation	Color	Hard or Soft	Top	Bottom	Oil, Gas or Water	Depth Found	Remarks
Salt			1600	1780			
Maxon			1800	1840			
B. Lime			1875	1940			
Injun			1940	2040			
Gordon			2675	2699 ?		2700	

