

New Location
 Drill Deeper
 Abandonment

Company BROADWATER, WELCH & TRAVIS
 Address WEST UNION, W. VA
 Farm DOSSY LEMASTER
 Tract _____ Acres 100 Lease No. _____
 Well (Farm) No. 3 Serial No. _____
 Elevation (Spirit Level) 1209
 Quadrangle CENTERPOINT
 County DODDRIDGE District McCLELLAN
 Engineer B. F. RINEHART
 Engineer's Registration No. 648
 File No. _____ Drawing No. 686-MD
 Date Sept. 29, 1949 Scale 1 in. = 500 ft.

STATE OF WEST VIRGINIA
 DEPARTMENT OF MINES
 OIL AND GAS DIVISION
 CHARLESTON

WELL LOCATION MAP
 FILE NO. DOD-798-A

+ Denotes location of well on United States Topographic Maps, scale 1 to 62,500, latitude and longitude lines being represented by border lines as shown.
 — Denotes one inch spaces on border line of original tracing.



STATE OF WEST VIRGINIA
DEPARTMENT OF MINES
OIL AND GAS DIVISION

691

WELL RECORD

Permit No. 178-A

Oil or Gas Well Oil
(KIND)


Company Broadwater, Welch and Travis
 Address West Union or Pennsboro, W. Va.
 Farm Isaac Ice Acres 100
 Location (waters) Beverlyn Fork
 Well No. 3 Elev. 1209
 District McClellan County Dodd
 The surface of tract is owned in fee by Dossy Lemasters
Alvy, W. Va. Address _____
 Mineral rights are owned by Isaac Ice Hrs.
West Union, W. Va. Address Route
 Drilling commenced no record
 Drilling completed _____
 Date Shot 7-29-20 ft. 2322 To _____
 With 60 Qts.

Casing and Tubing	Used in Drilling	Left in Well	Packers
Size			Kind of Packer
16			
13			
10	<u>444</u>	<u>pulled</u>	Size of
8 1/4	<u>1354</u>	<u>"</u>	
6 5/8	<u>2264</u>	<u>2264</u>	Depth set
5 3/16	<u>no record</u>		
3			Perf. top
2			Perf. bottom
Liners Used			Perf. top
			Perf. bottom

Open Flow _____ /10ths Water in _____ Inch
 _____ /10ths Merc. in _____ Inch
 Volume _____ Cu. Ft.
 Rock Pressure _____ lbs. _____ hrs.
 Oil _____ bbls., 1st 24 hrs.
 Fresh water _____ feet _____ feet
 Salt water _____ feet _____ feet

CASING CEMENTED _____ SIZE _____ No. Ft. _____ Date _____
 COAL WAS ENCOUNTERED AT 905 FEET _____ INCHES
 _____ FEET _____ INCHES FEET _____ INCHES
 _____ FEET _____ INCHES FEET _____ INCHES

Formation	Color	Hard or Soft	Top	Bottom	Oil, Gas or Water	Depth Found	Remarks
<u>Pgh Coal</u>			<u>905</u>				
<u>Big Lime</u>			<u>2200</u>				
<u>Big Ingun</u>			<u>2240</u>				
<u>Total Depth</u>			<u>2339</u>		<u>Oil</u>	<u>2325</u>	

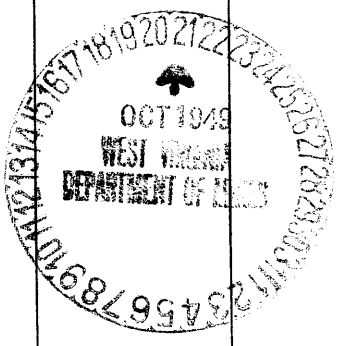

Formation	Color	Hard or Soft	Top	Bottom	Oil, Gas or Water	Depth Found	Remarks

Date June, 4 - 1949, 19

APPROVED Broadwater, Welch & Travis, Owner

By C. O. Travis Partner
(Title)

