

New Location   
 Drill Deeper   
 Abandonment

Company BROADWATER, WELCH & TRAVIS  
 Address WEST UNION, W.V.A.  
 Farm EZRA TRADER  
 Tract \_\_\_\_\_ Acres 82 Lease No. \_\_\_\_\_  
 Well (Farm) No. 2 Serial No. \_\_\_\_\_  
 Elevation (Spirit Level) 1040  
 Quadrangle CENTERPOINT  
 County DODDRIDGE District MCCLELLAN  
 Engineer B. F. RINEHART  
 Engineer's Registration No. 648  
 File No. \_\_\_\_\_ Drawing No. 685-MD  
 Date Sept. 29, 1949 Scale 1 in = 500 ft.

STATE OF WEST VIRGINIA  
 DEPARTMENT OF MINES  
 OIL AND GAS DIVISION  
 CHARLESTON

**WELL LOCATION MAP**  
 FILE NO. DOD-799-A-#2

+ Denotes location of well on United States Topographic Maps, scale 1 to 62,500, latitude and longitude lines being represented by border lines as shown.  
 - Denotes one inch spaces on border line of original tracing.



STATE OF WEST VIRGINIA  
DEPARTMENT OF MINES  
OIL AND GAS DIVISION

692

WELL RECORD

Permit No. 799-A Oil or Gas Well Oil  
(KIND)


Company Broadwater, Welch & Travis  
Address West Union or Pennsboro, W. Va.  
Farm B. Lemasters Acres 92  
Location (waters) Beverly fork  
Well No. 2 Elev. 1040  
District McClellan County Dodd  
The surface of tract is owned in fee by Ezra Inader  
West Union Address W Va  
Mineral rights are owned by B. Lemasters  
West Union Address W Va  
Drilling commenced no record  
Drilling completed " "  
Date Shot 6-15-97 From at 2171 To \_\_\_\_\_  
With \_\_\_\_\_  
Open Flow \_\_\_\_\_ /10ths Water in \_\_\_\_\_ Inch  
\_\_\_\_\_ /10ths Merc. in \_\_\_\_\_ Inch  
Volume \_\_\_\_\_ Cu. Ft.  
Rock Pressure \_\_\_\_\_ lbs. \_\_\_\_\_ hrs.  
Oil \_\_\_\_\_ bbls., 1st 24 hrs.  
Fresh water \_\_\_\_\_ feet \_\_\_\_\_ feet  
Salt water \_\_\_\_\_ feet \_\_\_\_\_ feet

Casing and Tubing	Used in Drilling	Left in Well	Packers
Size			
16			Kind of Packer
13			
10	465	465	Size of
8 1/4	1150	1150	
6 3/4	2115	2115	Depth set
5 3/16			
3			Perf. top
2			Perf. bottom
Liners Used			Perf. top
			Perf. bottom

CASING CEMENTED \_\_\_\_\_ SIZE \_\_\_\_\_ No. Ft. \_\_\_\_\_ Date \_\_\_\_\_

COAL WAS ENCOUNTERED AT 736 FEET \_\_\_\_\_ INCHES  
\_\_\_\_\_ FEET \_\_\_\_\_ INCHES FEET \_\_\_\_\_ INCHES  
\_\_\_\_\_ FEET \_\_\_\_\_ INCHES FEET \_\_\_\_\_ INCHES

Formation	Color	Hard or Soft	Top	Bottom	Oil, Gas or Water	Depth Found	Remarks
Pgh. Coal			736				
Big Lime			1970				
Big Ingun			2085				
Total Depth				2188	Gas Oil	2163 2174	

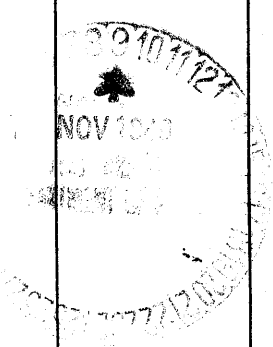

Formation	Color	Hard or Soft	Top	Bottom	Oil, Gas or Water	Depth Found	Remarks

Date June, 4- 1949, 19

APPROVED Broadwater, Welch & Travis, Owner

By C. O. Travis Partner  
(Title)