

804-A-#1 | S 333  
 | W 222  
 805-A-#3 | S 333  
 | W 220

New Location..   
 Drill Deeper.....   
 Abandonment.....

Company RENO OIL CO.  
 Address SISTERSVILLE, W. VA.  
 Farm H. C. PRITCHARD  
 Tract \_\_\_\_\_ Acres 75 Lease No. \_\_\_\_\_  
 Well (Farm) No. 1 & 3 Serial No. \_\_\_\_\_  
 Elevation (Spirit Level) 1106 & 1054  
 Quadrangle WEST UNION  
 County DODDRIDGE District CENTRAL  
 Engineer B. F. RINEHART  
 Engineer's Registration No. 648  
 File No. \_\_\_\_\_ Drawing No. 700-CD  
 Date Dec. 20, 1949 Scale 1 in. = 400 ft.

STATE OF WEST VIRGINIA  
 DEPARTMENT OF MINES  
 OIL AND GAS DIVISION  
 CHARLESTON

**WELL LOCATION MAP**  
 FILE NO. DOD-804-A-#1  
DOD-805-A-#3

+ Denotes location of well on United States Topographic Maps, scale 1 to 62,500, latitude and longitude lines being represented by border lines as shown.

- Denotes one inch spaces on border line of original tracing.

H. C. FRITCHARD NO. 1 WELL.  
(Formerly JANE RIDDLE).

804A

Central District, Doddridge County, W. Va.  
By Rose Oil Co., Sistersville, W. Va.  
Abandoned under permit No. ....-A7  
Co. ....

Elevation, ..... L.

Surface owned by H. C. Fritchard, R. F. D., West Union, W. Va.

Drilling completed Sept. 23, 1918.

Shot Sept. 25, 1918.

10" casing, 292' (pulled); 8", 1230' (pulled); 6", 1625'; 5", 2007'.

Oil well. Record to Dept. of Mines dated Dec. 28, 1949.

Record to ROT from Mrs. Griffith May 26, 1950. Old File No. 706.

	Top.	Bottom.
Little Dunkard Sand	1150	- 1150
Big Dunkard Sand	1275	- 1370
1st Salt Sand	1495	- 1595
Horton Sand (water, 1947')	1900	- 1954
Break	1954	- 1959
Little Lime	1959	- 1984
Pencil Cove	1984	- 1992
Big Lime	1995	- 2075
Big Injun Sand	2075	- 2119
Total depth		2119

STATE OF WEST VIRGINIA  
DEPARTMENT OF MINES  
OIL AND GAS DIVISION

706

WELL RECORD

Permit No. 800-804-A


Oil or Gas Well Oil  
(KIND)

Company Reno Oil Company  
Address Sistersville, W. Va.  
Farm H. C. Pritchard  
Formerly Jane Riddle Acres.....  
Location (waters).....  
Well No. 1 Elev. 1105  
District Central County Doddridge  
The surface of tract is owned in fee by H. C. Pritchard  
R.F.D. West Union, W. Va. Address.....  
Mineral rights are owned by..... Address.....  
Drilling commenced.....  
Drilling completed September 23rd, 1918  
Date shot Sept. 25, 1918 Depth of shot.....  
Open Flow /10ths Water in..... Inch  
/10ths Merc. in..... Inch  
Volume..... Cu. Ft.  
Rock Pressure..... lbs..... hrs.  
Oil..... bbls., 1st 24 hrs.  
Fresh water..... feet..... feet  
Salt water..... feet..... feet

Casing and Tubing	Used in Drilling	Left in Well	Packers
Size			Kind of Packer
16.....			
13.....			
10.....	292	None	Size of
8 1/4.....	1230	None	
6 3/8.....	1625	1625	Depth set
5 3/16.....	2007	2007	
3.....			Perf. top
2.....			Perf. bottom
Liners Used.....			Perf. top
			Perf. bottom

CASING CEMENTED..... SIZE..... No. Ft..... Date.....  
COAL WAS ENCOUNTERED AT..... FEET..... INCHES.....  
..... FEET..... INCHES..... FEET..... INCHES.....  
..... FEET..... INCHES..... FEET..... INCHES.....

Formation	Color	Hard or Soft	Top	Bottom	Oil, Gas or Water	Depth Found	Remarks
Little Dunkard			1150	1180			
Big Dunkard			1275	1330			
1st Salt Sand			1495	1595			
Maxon Sand			1900	1954			
Water			1947				
Break			1954	1959			
Little Lime			1959	1984			
Pencil Cave			1984	1992			
Big Lime			1995	2075			
Injun Sand			2075	2119			
Depth of well			2119				

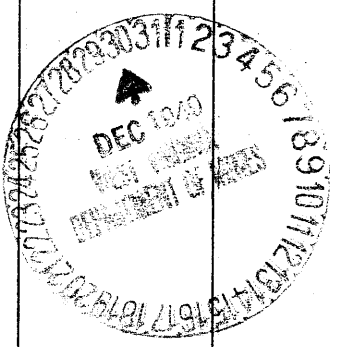

was  
017 71109

