

Surface owned by W. H. Cayton Hrs.
 Address: Mr. D. J. Cayton, R.F.D. No. 2, Salem, W. Va.
 Coal owned by Willis G. Tetrick, Jr. et al.
 Address: Mr. Willis G. Tetrick, Jr. P.O. Box 267, Clarksburg, W. Va.

- New Location...
 Drill Deeper...
 Abandonment...

On 800' Map N28. Sqs. S9 E2.

Company William Moses
 Address Salem, W. Va.
 Farm W. H. Cayton
 Tract _____ Acres 62 1/2 Lease No. _____
 Well (Farm) No. 1 Serial No. _____
 Elevation (Spirit Level) Floor - 933.10
Ground - 932.00
 Quadrangle Centerpoint
 County Doddridge District McClellan
 Engineer Elsworth Haines
 Engineer's Registration No. 2221
 File No. _____ Drawing No. _____
 Date Feb. 23rd, 1950 Scale 1" = 400 Feet

STATE OF WEST VIRGINIA
 DEPARTMENT OF MINES
 OIL AND GAS DIVISION
 CHARLESTON

WELL LOCATION MAP
 FILE NO. DOD-815-A

+ Denotes location of well on United States Topographic Maps, scale 1 to 62,500, latitude and longitude lines being represented by border lines as shown.

- Denotes one inch spaces on border line of original tracing.

McClellan District, Doddridge County, W. Va.

By William Moses, Salem, W. Va.

Abandoned under permit Red-.....-A?

On 62.5 acres.

Elevation, 932' L.

Surface owned by William Moses, Salem, W. Va., and minerals by Willis G.

Petrick, Box 267, Clarksburg, W. Va.

Drilling completed 5/23 (May 1923?)


10" casing, 191'; 5", 2385'; all left in.

Coal was encountered at 725-733'.

Oil well. Record to Dept. of Mines stamped March 6, 1950.

Record to RCT from Mrs. Griffith May 26, 1950. Old File No. 701.

	Top.	Bottom.
Pittsburgh Coal	725	- 733
Dunkard Sand	1065	- 1146
Big Lime	1965	- 2010
Big Injun Sand	2010	- 2140
Fifty-foot Sand	2560	- 2600
Stray Sand	2758	- 2780
Gordon Sand	2800	- 2813
Total depth		2865

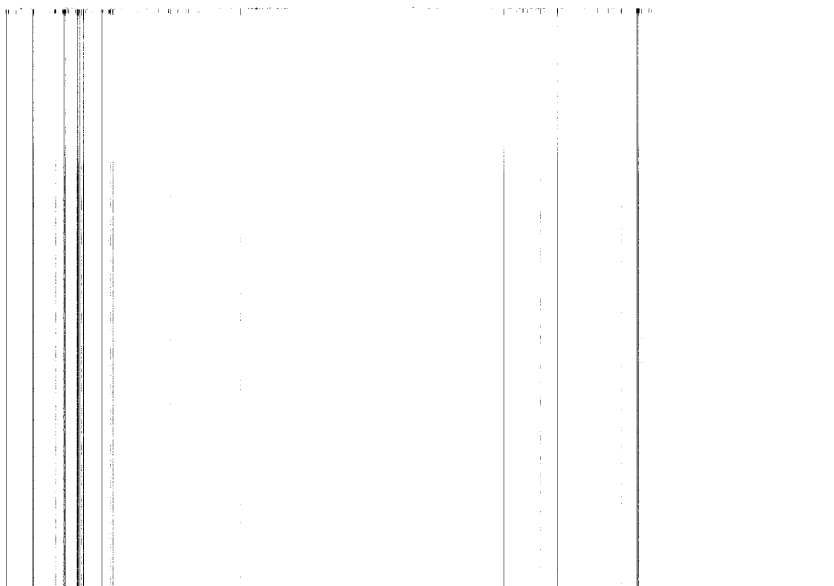



STATE OF WEST VIRGINIA
DEPARTMENT OF MINES
OIL AND GAS DIVISION

701

Permit No. 000-815-A

WELL RECORD

Oil or Gas Well Oil
(KIND)

Company William Moses.
Address Salem, W. Va.
Farm W. H. Gayton Acres 62.5
Location (waters) _____
Well No. One Elev. 932
District Macclolland County Doddridge.
The surface of tract is owned in fee by William Moses
Address Salem, W. Va.
Mineral rights are owned by Willis G. Tetrick,
Box 267 Address Clarksburg, W. Va.
Drilling commenced ?
Drilling completed 5/23
Date Shot _____ From _____ To _____
With _____

Casing and Tubing	Used in Drilling	Left in Well	Packers
Size			Kind of Packer _____
16			
13			
10		191	Size of _____
8 1/4			Depth set _____
6 5/8			
5 3/16		2385	Perf. top _____
3			Perf. bottom _____
2			Perf. top _____
Liners Used			Perf. bottom _____

Open Flow _____ /10ths Water in _____ Inch
_____ /10ths Merc. in _____ Inch
Volume _____ Cu. Ft.
Rock Pressure _____ lbs. _____ hrs.
Oil _____ bbls., 1st 24 hrs.
Fresh water _____ feet _____ feet
Salt water _____ feet _____ feet

CASING CEMENTED _____ SIZE _____ No. Ft. _____ Date _____
COAL WAS ENCOUNTERED AT **725** FEET _____ INCHES
_____ FEET _____ INCHES FEET _____ INCHES
_____ FEET _____ INCHES FEET _____ INCHES

Formation	Color	Hard or Soft	Top	Bottom	Oil, Gas or Water	Depth Found	Remarks
			725	733			
	Pittsburg Coal						
	Dunkard Sand		1065	1146			
	Big Lime		1965	2010			
	Big Injun		2010	2140			
	Fifty Foot		2560	2600			
	Strgy Sand		2758	2780			
	Gordon		2800	2813			
	Total Depth		2865				

56789
MAR 1950
WEST VIRGINIA
DEPARTMENT OF MINES

MAY 26 1950
(Over)