


Scale 1" = 400 Feet

Longitude 80° 30'

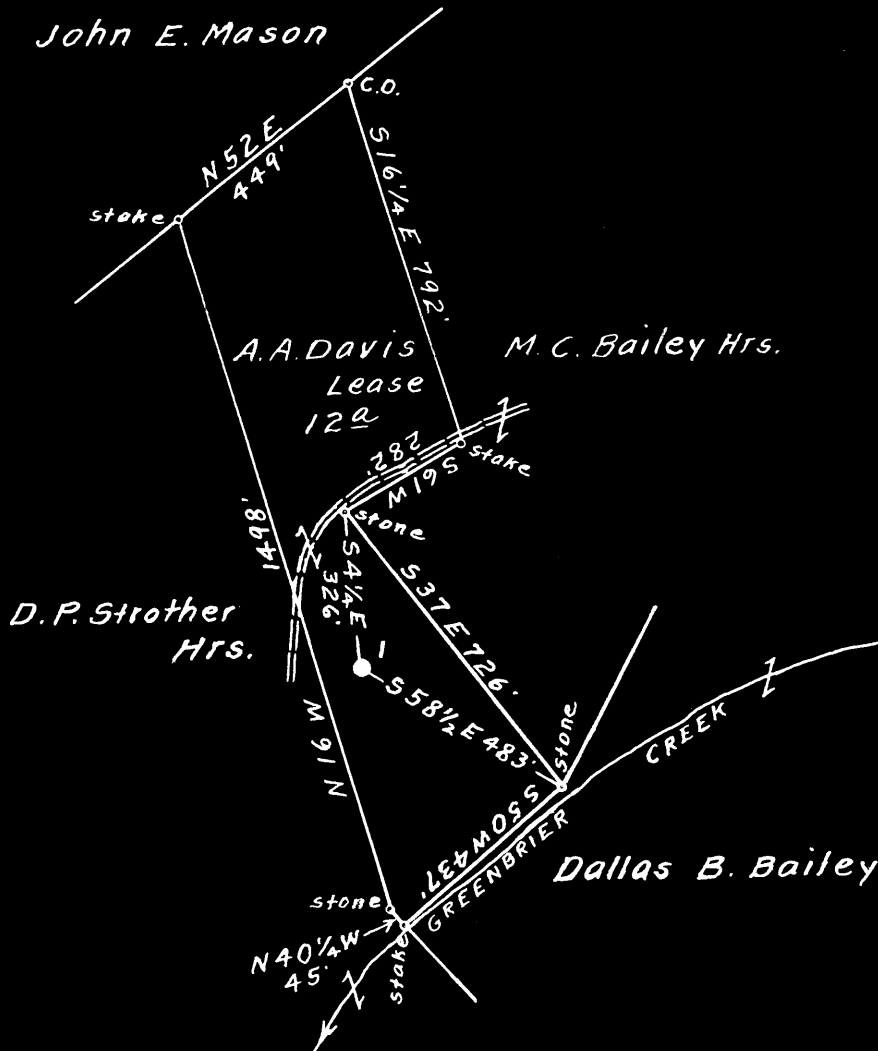

surface owned by D.P. Strother Hrs.
 Address: Mr. E. R. Strother, 20588. Dean Ave. Detroit, 34. Mich.
 Coal owned by Virginia A. Tetrick.
 Address: Mrs. Virginia A. Tetrick, P.O. Box No. 267. Clarksburg,
 W. Va.

New Location
 Drill Deeper
 Abandonment

On 800' Map N18. Sqs. S14 E2.

Company Salem Supply Co.
 Address Salem, W. Va.
 Farm A.A. Davis
 Tract _____ Acres 12. Lease No. _____
 Well (Farm) No. 1. Serial No. _____
 Elevation (Spirit Level) Floor - 1080.21
 Ground - 1077.87
 Quadrangle Vadis
 County Doddridge District Greenbrier
 Engineer Elsworth Haines
 Engineer's Registration No. 2221.
 File No. _____ Drawing No. _____
 Date July 21st, 1950. Scale 1" = 400 Feet

STATE OF WEST VIRGINIA
 DEPARTMENT OF MINES
 OIL AND GAS DIVISION
 CHARLESTON

WELL LOCATION MAP
 FILE NO. DOD-840-A

+ Denotes location of well on United States Topographic Maps, scale 1 to 62,500, latitude and longitude lines being represented by border lines as shown.

- Denotes one inch spaces on border line of original tracing.



STATE OF WEST VIRGINIA
DEPARTMENT OF MINES
OIL AND GAS DIVISION

711

WELL RECORD

Permit No. 800-940 - A

Oil or Gas Well _____ (KIND)

Company Salem Supply Co.
 Address Salem, W. Va.
 Farm A.A. Davis Acres _____
 Location (waters) One
 Well No. _____ Elev. 2077.87
 District Greenbrier County Doddridge
 The surface of tract is owned in fee by _____
 Address _____
 Mineral rights are owned by _____
 Address _____
 Drilling commenced 4/7/1902
 Drilling completed 5/27/1902
 Date Shot _____ From _____ To _____
 With _____
 Open Flow _____ /10ths Water in _____ Inch
 _____ /10ths Merc. in _____ Inch
 Volume _____ Cu. Ft.
 Rock Pressure _____ lbs. _____ hrs.
 Oil _____ bbls., 1st 24 hrs.
 Fresh water _____ feet _____ feet
 Salt water _____ feet _____ feet

Casing and Tubing	Used in Drilling	Left in Well	Packers
Size			Kind of Packer
16			
13			
10			Size of
8 1/4		2222	Depth set
6 1/2			
5 3/16			
3			Perf. top
2			Perf. bottom
Liners Used			Perf. top
			Perf. bottom

CASING CEMENTED _____ SIZE _____ No. Ft. _____ Date _____

COAL WAS ENCOUNTERED AT 760 FEET 60 INCHES
 _____ FEET _____ INCHES _____ FEET _____ INCHES
 _____ FEET _____ INCHES _____ FEET _____ INCHES

Formation	Color	Hard or Soft	Top	Bottom	Oil, Gas or Water	Depth Found	Remarks
PEh Coal			760	765			
Dunkard			1230	1240			
Salt			1485	1790			
maxon			2000	2045			
injun			2000	2130			
Gordon			2830	2856	total depth		

