

S 1.26
W 3.71

- New Location
- Drill Deeper
- Abandonment

Survey & Plat *A. K. Westfall*

Company *Broadwater, Welch & Travis*
 Address *Pennsboro, W. Va.*
 Farm *Ocie Smith*
 Tract _____ Acres *80* Lease No. _____
 Well (Farm) No. *34* Serial No. _____
 Elevation (Spirit Level) *871*
 Quadrangle *Centerpoint*
 County *Tyler* District *Mc Elroy*
 Engineer *W. F. Kuchert*
 Engineer's Registration No. *648*
 File No. _____ Drawing No. _____
 Date *Dec 3, 1948* Scale *1" = 40 Poles*

STATE OF WEST VIRGINIA
 DEPARTMENT OF MINES
 OIL AND GAS DIVISION
 CHARLESTON

WELL LOCATION MAP
 FILE NO. *DOD 842-A #34*


+ Denotes location of well on United States Topographic Maps, scale 1 to 62,500, latitude and longitude lines being represented by border lines as shown.

- Denotes one inch spaces on border line of original tracing.

39° 25'

LATITUDE

30° 42' 30"

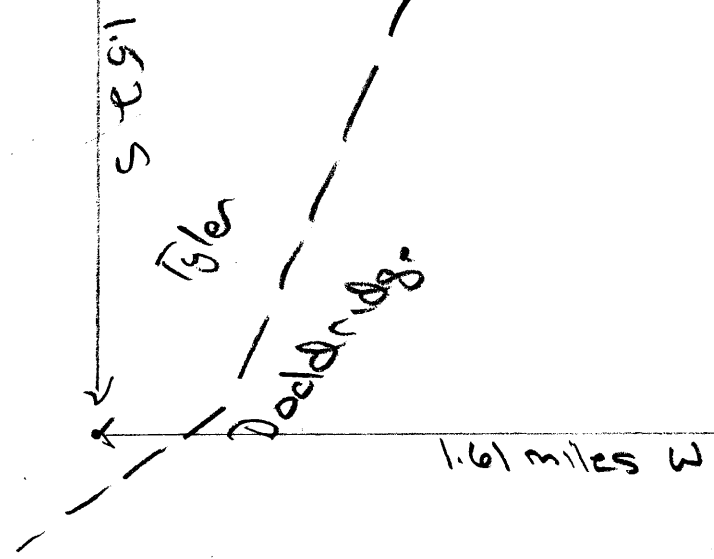

Note:
 This well
 falls in
 Tyler Co

spudded - 10/05/1896
 Comp. - 01/04/1897
 initial prod 40 BOPD
 lease record in
 UIC Permit for 0951284
 4a slab

7'5 OGIS topo location

7.5' loc 1.52 S 15' loc 1.52
1.61 W (calc.) 3.84 W

Company S. Penn
Silas Langfitt
 Farm Dave Smith 34
 Quad Center Point + 15' WC
 County Tyler
 District _____

WELL LOCATION MAP
 File No. Dodd 30842

McClelland Dodd
 McIlroy District, Tyler County, W. Va.
 By Broadwater, Welch & Travis, West Union or Pennsboro, W. Va.
 Abandoned under permit Tyl-.....-A7
 On 80 acres, on McIlroy Creek.
 Elevation, 871' L.
 Surface owned by Cole Smith, West Union, W. Va., and minerals by
 Silas Langfitt Heirs, West Union, W. Va.
 No record of date of completion, etc.
 Shot Sept. 6, 1911, at 2012', with 40 qts.
 No record of water.
 10" casing, 306' (pulled); 8", 1092' (pulled); 6", 1929'; 2" tubing,
 2035' (pulled).
 Coal was encountered at 602'.
 Oil well. Record to Dept. of Mines dated Jan. 3, 1950.
 Record to NCT from Mrs. Griffith Sept. 9, 1950. Old File No. 555.

	Top.	Bottom.
Coal	602 -	...
Big Injun Sand (oil, 2014')	1930 -
Total depth		2040