

New Location
 Drill Deeper
 Abandonment

Map Sh 58 S17 E2 FB. 927 P-12.

Company Hope Natural Gas Co.
 Address Clarksburg, W.Va.
 Farm Slusser Hrs.
 Tract _____ Acres 124 Lease No. 32588
 Well (Farm) No. _____ Serial No. 4583
 Elevation (Spirit Level) 1238'
 Quadrangle Vadis NC
 County Doddridge District Greenbrier
 Engineer W.M. Bowers
 Engineer's Registration No. 900
 File No. _____ Drawing No. _____
 Date 9-11-50 Scale 1" = 40 P

STATE OF WEST VIRGINIA
 DEPARTMENT OF MINES
 OIL AND GAS DIVISION
 CHARLESTON

WELL LOCATION MAP
 FILE NO. DOD-848-A

+ Denotes location of well on United States Topographic Maps, scale 1 to 62,500, latitude and longitude lines being represented by border lines as shown.

- Denotes one inch spaces on border line of original tracing.

"IMPERIAL" TRACING CLOTH
 K & E CO., N. Y.



STATE OF WEST VIRGINIA
DEPARTMENT OF MINES
OIL AND GAS DIVISION

750

Permit No.

Rad-848/B2

WELL RECORD

Other Gas Well

(KIND)


Company Hope Natural Gas Company
 Address 445 West Main St., ~~Greenbrier~~, W.Va.
 Farm Slusser Hrs. Acres 124
 Location (waters) Bennets Fork
 Well No. 4583 Elev. 1238'
 District Greenbrier County Doddridge
 The surface of tract is owned in fee by Audrey Spurgeon
 Address West Union, W.Va.
 Mineral rights are owned by do
 Address _____
 Drilling commenced 1915 (Not Rec.)
 Drilling completed 1915 "
 Date Shot _____ From _____ To _____
 With _____
 Open Flow _____ /10ths Water in _____ Inch
 _____ /10ths Merc. in _____ Inch
 Volume _____ Cu. Ft.
 Rock Pressure _____ lbs. _____ hrs.
 Oil _____ bbls., 1st 24 hrs.
 Fresh water _____ feet _____ feet
 Salt water 1600 feet _____ feet

Casing and Tubing	Used in Drilling	Left in Well	Packers
Size			
16			Kind of Packer
13			
10	342	0	Size of
8 1/4	1618	0	
6 5/8	2255	2255	Depth set
5 3/16	2802	2802	
3			Perf. top
2			Perf. bottom
Liners Used			Perf. top
			Perf. bottom

CASING CEMENTED not SIZE _____ No. Ft. _____ Da _____

COAL WAS ENCOUNTERED AT 840 FEET 36 INCHES
 _____ FEET _____ INCHES _____ FEET _____ INCHES
 _____ FEET _____ INCHES _____ FEET _____ INCHES

Formation	Color	Hard or Soft	Top	Bottom	Oil, Gas or Water	Depth Found	Remarks
Pgh Coal			840	843			
Dunkard			1205	1360			
Salt Sand			1565	1950	Water	1600	
INJUN			2250	2350	Gas	2330	
Thirty Foot			2790	2806	Gas		
Stray			2871	2883	Gas	2871	
Gordon			2911	2930		2914	
Total Depth				2952			

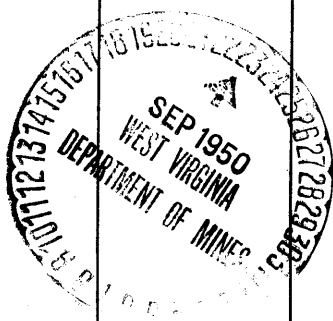

U

Formation	Color	Hard or Soft	Top	Bottom	Oil, Gas or Water	Depth Found	Remarks

Date September 22, 195

APPROVED Hope Natural Gas Company, O

By _____ (Title)

G.E. Morgan