

- New Location...
- Drill Deeper.....
- Abandonment.....

S 0.58  
W 3.49

Map Sh 55 S 15 E 3 FB. 920 P. 19-20

Company	Hope Natural Gas Co.
Address	Clarksburg, W. Va.
Farm	F.M. Saddler
Tract	Acres 85 Lease No. 13194
Well (Farm) No.	Serial No. 3177
Elevation (Spirit Level)	1289'
Quadrangle	Vadis NE
County	Doddridge District Greenbrier
Engineer	Wm Bowers
Engineer's Registration No.	900
File No.	Drawing No.
Date	9-1-50 Scale 1"=30 P

STATE OF WEST VIRGINIA  
DEPARTMENT OF MINES  
OIL AND GAS DIVISION  
CHARLESTON

**WELL LOCATION MAP**  
FILE NO. DOD - 849-A

+ Denotes location of well on United States Topographic Maps, scale 1 to 62,500, latitude and longitude lines being represented by border lines as shown.

- Denotes one inch spaces on border line of original tracing.



STATE OF WEST VIRGINIA  
DEPARTMENT OF MINES  
OIL AND GAS DIVISION

749

WELL RECORD

Permit No. 204-849A32


Oil or Gas Well (KIND)

Company Hope Natural Gas Company  
Address 445 West Main Street, Clarksburg, W. Va.  
Farm F. M. Saddler Acres 85  
Location (waters) \_\_\_\_\_  
Well No. 3177 Elev. 1289'  
District Greenbrier County Doddridge  
The surface of tract is owned in fee by Mrs. Mae Davis  
Address R#3, Salem, W. Va.  
Mineral rights are owned by do  
Address \_\_\_\_\_  
Drilling commenced Dec. 2, 1913  
Drilling completed Feb. 8, 1914  
Date Shot \_\_\_\_\_ From \_\_\_\_\_ To \_\_\_\_\_  
With \_\_\_\_\_  
Open Flow \_\_\_\_\_ /10ths Water in \_\_\_\_\_ Inch  
\_\_\_\_\_ /10ths Merc. in \_\_\_\_\_ Inch  
Volume \_\_\_\_\_ Cu. Ft.  
Rock Pressure \_\_\_\_\_ lbs. \_\_\_\_\_ hrs.  
Oil \_\_\_\_\_ bbls., 1st 24 hrs.  
Fresh water none feet \_\_\_\_\_ feet  
Salt water none feet \_\_\_\_\_ feet

Casing and Tubing	Used in Drilling	Left in Well	Packers
Size			
16			Kind of Packer
13			
10	483'	483'	Size of
8 1/4	1385'	1385'	
6 5/8	2303'	2303'	Depth set
5 3/16	2840'	2840'	
3			Perf. top
2	3001	0	Perf. bottom
Liners Used			Perf. top
			Perf. bottom

CASING CEMENTED not SIZE \_\_\_\_\_ No. Ft. \_\_\_\_\_  
COAL WAS ENCOUNTERED AT 890 FEET 60 INCHES  
\_\_\_\_\_ FEET \_\_\_\_\_ INCHES \_\_\_\_\_ FEET \_\_\_\_\_ INCHES  
\_\_\_\_\_ FEET \_\_\_\_\_ INCHES \_\_\_\_\_ FEET \_\_\_\_\_ INCHES

Formation	Color	Hard or Soft	Top	Bottom	Oil, Gas or Water	Depth Found	Remarks
Pgh. Coal			890	895			
L. Dunkard			1107	1135			
Gas Sand			1380	1405			
First Salt			1610	1640			
2nd Salt			1695	1740			
MAXON			2045	2090			
L. Lime			2167	2183			
Pencil Cave			2183	2206			
Big Lime			2206	2300			
BIG INJUN			2300	2375			
SQUAW			2385	2392			
GANTZ			2605	2612			
FIFTY FOOT			2705	2717			
THIRTY FOOT			2844	2874	Gas	2865	show
GORDON			2925	2951	"	2939 & 2949	
FOURTH			2973	2993	"	2980-2986	
TOTAL DEPTH				3001			

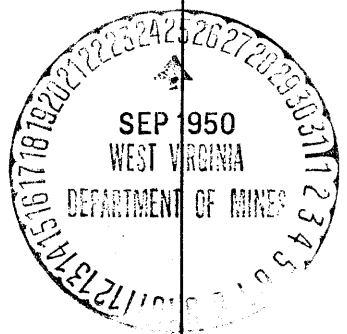

(Over) FEB 23 1951

Formation	Color	Hard or Soft	Top	Bottom	Oil, Gas or Water	Depth Found	Remarks

Date September 21, 1950

APPROVED Hope Natural Gas Company, Own

By \_\_\_\_\_ (Title)

*QEM*

(Title)