

Company BRADFORD SUPPLY CO.

Address Box 526, Charleston, W. Va.

Farm Nathan Kelley

Tract Acres 1.93 Lease No. _____

Well (Farm) No. One Serial No. _____

Elevation (Spirit Level) 1190'

Quadrangle Centerpoint **SW**

County Doddridge District New Milton

Engineer W. Abbott

Engineer's Registration No. 1527

File No. _____ Drawing No. _____

Date Nov. 1950 Scale 1"=100'

STATE OF WEST VIRGINIA
 DEPARTMENT OF MINES
 OIL AND GAS DIVISION
 CHARLESTON

WELL LOCATION MAP
 FILE NO. DOD-857-A

+ Denotes location of well on United States
 Topographic Maps, scale 1 to 62,500, lat-
 itude and longitude lines being represented
 by border lines as shown.

- Denotes one inch spaces on border line
 of original tracing.



771

STATE OF WEST VIRGINIA
DEPARTMENT OF MINES
OIL AND GAS DIVISION

WELL RECORD

Permit No. 001-857-A

Oil or Gas Well GAS
(KIND)


Company BRADFORD SUPPLY COMPANY
Address BOX 526, CHARLESTON, 22 W. VA.
Farm Nathan Kelly Acres 21 83/160
Location (waters) Sugar Camp Run
Well No. #1 Serial #1014 Elev. 1190
District New Milton County Doddridge
The surface of tract is owned in fee by George Kelly,
Address Blandville, W. Va.
Mineral rights are owned by R. E. Kelly & Mrs. Jane
Kelly, Address Long Run, W. Va.
Drilling commenced _____
Drilling completed 3-13-24
Date Shot SEE BELOW From _____ To _____
With _____
Open Flow 40 /10ths Water in Three Inch
~~25~~ /10ths Merc. in _____ Inch
Volume 684,000 Cu. Ft.
Rock Pressure 425 lbs. _____ hrs.
Oil _____ bbls., 1st 24 hrs.
Fresh water _____ feet _____ feet
Salt water _____ feet _____ feet

Casing and Tubing	Used in Drilling	Left in Well	Packers
Size			Kind of Packer
16			
13			
10			Size of
8 3/4	<u>1411'</u>	<u>1411'</u>	
6 5/8	<u>2221'</u>		Depth set
5 3/16			
3			Perf. top
2	<u>2417'</u>		Perf. bottom
Liners Used			Perf. top
			Perf. bottom

CASING CEMENTED _____ SIZE _____ No. Ft. _____ Date _____
COAL WAS ENCOUNTERED AT 285 FEET 60 INCHES
875 FEET 60 INCHES FEET INCHES
FEET INCHES FEET INCHES

Formation	Color	Hard or Soft	Top	Bottom	Oil, Gas or Water	Depth Found	Remarks
Conductor				<u>9'</u>			
Native Coal			<u>285'</u>	<u>290'</u>			
Sand			<u>815'</u>	<u>875'</u>			
Pittsburgh Coal			<u>875'</u>	<u>880'</u>			
Sand			<u>915'</u>	<u>960'</u>			
Big Dunkard Sand			<u>1411'</u>	<u>1454'</u>			
Gas Sand			<u>1542'</u>	<u>1600'</u>			
1st Salt Sand			<u>1640'</u>	<u>1690'</u>			
2nd Salt Sand			<u>1695'</u>	<u>1858'</u>			
3rd Salt Sand			<u>1948'</u>	<u>2010'</u>			
Little Lime			<u>2174'</u>	<u>2195'</u>			
Pencil Cave			<u>2195'</u>	<u>2215'</u>			
Big Lime			<u>2215'</u>	<u>2260</u>			
Big Injun Sand			<u>2260'</u>	<u>2365'</u>	Gas	<u>2265-2268'</u>	
					"	<u>2278-2280'</u>	
					"	<u>2300-2312'</u>	
				<u>2418'</u>			
<u>SHOT RECORD</u>							
			Shot <u>4-21-24</u> with <u>12</u> Qts. from <u>2300'</u> to <u>2312'</u>				
			" <u>4-21-24</u> " <u>5</u> " " <u>2372'</u> to <u>2277'</u>				

COMPLETED 8-4-51
TUBING & CASING RECOVERED
2" OR 3" PULLED _____ LOST
5-3/16" PULLED _____ LOST
6-5/8" PULLED _____ LOST
8 1/4" PULLED 889' LOST 522'
10" PULLED _____ LOST

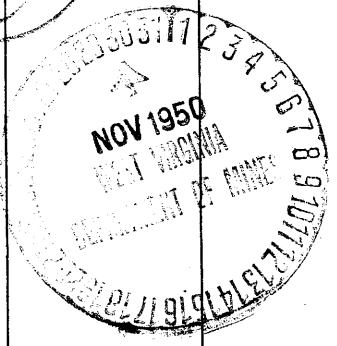

Wad 017 72453

New Milton District, Radridge County, W. Va.
 by Bradford Supply Co., Box 526, Charleston, 22, W. Va.
 Abandoned under permit No.-17
 On 21-87/160 acres, on Sugarcamp Run.
 Elevation, 1190' L.
 Surface owned by George Kelly, Blainville, W. Va., and minerals by
 S. W. Kelly and Mrs. Jane Kelly, Long Run, W. Va.
 Drilling completed March 17, 1934.
 Shot April 21, 1934, with 12 qts., at 2300-2312'.
 Shot April 21, 1934, with 5 qts., at 2272-2277'.
 Open flow, 40/10 W. in 3".
 Volume 634,000 cu. ft.
 Rock pressure, 405 lbs.
 8 1/2" casing, 1411'; 6" casing, 2221'; 2" tubing, 2417'.
 Coal was encountered at 285-290 and 875-880'.
 Gas well. Record to Dept. of Mines dated Nov. 27, 1950.
 Plugging record: Completed 8-4-51. 8 1/2" casing, pulled 889', lost 522'.
 Gas well. Record to DOT from Mrs. Griffith Aug. 27, 1951. Old file No. 77

	Top.	Bottom.
Contractor	0	9
Native coal	285	290
Sand	815	875
Pittsburgh Coal	875	880
Sand	915	960
Big Bedford Sand	1411	1454
Gas Sand	1542	1600
1st Salt Sand	1640	1690
2nd Salt Sand	1695	1898
3rd Salt Sand	1948	2010
Little line	2174	2195
Pencil Core	2195	2215
Big line	2215	2260
Big Injun Sand (gas, 2269-2268'; gas, 2278-2280'; gas, 2300-2312')	2260	2365
Total depth		2418