

New Location...
 Drill Deeper...
 Abandonment... 1093

FEB 18 1952
 Map 545 S1E3 FB556P17-18 FB996P26-27

Company Hope Natural Gas Co
 Address Clarksburg, W.Va.
 Farm Smith-Robinson
 Tract _____ Acres 295 Lease No. 13091
 Well (Farm) No. 1093 Serial No. As Shown
 Elevation (Spirit Level) As Shown
 Quadrangle Centerpoint
 County Doddridge District McClellan
 Engineer Wm Bowers
 Engineer's Registration No. 900
 File No. _____ Drawing No. _____
 Date 4-5-51 Scale 1" = 40P

STATE OF WEST VIRGINIA
 DEPARTMENT OF MINES
 OIL AND GAS DIVISION
 CHARLESTON

WELL LOCATION MAP
 FILE NO. DOD-876-A

+ Denotes location of well on United States Topographic Maps, scale 1 to 62,500, latitude and longitude lines being represented by border lines as shown.

- Denotes one inch spaces on border line of original tracing.



772

STATE OF WEST VIRGINIA
DEPARTMENT OF MINES
OIL AND GAS DIVISION

WELL RECORD

Permit No. 000-876-A


EDGE Gas Well (KIND)

Company Hope Natural Gas Company.
 Address 445 West Main St. Clarksburg, W. Va.
 Farm Smith Robinson Acres 295
 Location (waters) _____
 Well No. 1093 Elev. 1287
 District McClellan County Doddridge
 The surface of tract is owned in fee by _____
 Address _____
 Mineral rights are owned by _____
 Address _____
 Drilling commenced May 24, 1908
 Drilling completed June 26, 1908
 Date Shot _____ From _____ To _____
 With _____
 Open Flow _____ /10ths Water in _____ Inch
 _____ /10ths Merc. in _____ Inch
 Volume _____ Cu. Ft.
 Rock Pressure _____ lbs. _____ hrs.
 Oil _____ bbls., 1st 24 hrs.
 Fresh water none recorded feet _____ feet
 Salt water none recorded feet _____ feet

Casing and Tubing	Used in Drilling	Left in Well	Packers
Size			Kind of Packer
16			
13			
10	255	255	Size of
8 1/4	1473	1473	
6 5/8	2260	2260	Depth set
5 3/16	3020	3020	
3			Perf. top
2	3150	3150	Perf. bottom
Liners Used			Perf. top
			Perf. bottom

NOT
 CASING CEMENTED _____ SIZE _____ No. Ft. _____ Dat _____
 COAL WAS ENCOUNTERED AT 980 FEET 60 INCHES
 _____ FEET _____ INCHES FEET _____ INCHES
 _____ FEET _____ INCHES FEET _____ INCHES

Formation	Color	Hard or Soft	Top	Bottom	Oil, Gas or Water	Depth Found	Remarks
Pittsburgh Coal			980	985			
Big Dunkard Gas sand			1443 1700	1500 1775			
Salt sand			1819	1950			
Little Lime			2215	2225			
Big Lime			2280	2310			
Big Injun			2310	?	gas	2395	
Fifty foot			2588	2599			
Gordon stray			3017	3060	gas	3052	
Gordon			3061	3076	gas	3074	
Fourth			3094	3099			
Total depth				3150			

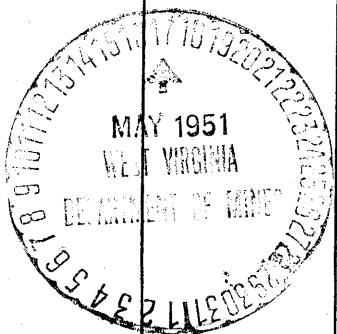

SMITH ROBINSON NO. 1093 WELL.

McClellan District, Doddridge County, W. Va.
 By Hope Natural Gas Co., 445 W. Main St., Clarksburg, W. Va.
 Abandoned under permit Dod-.....-A?
 On 295 acres.
 Elevation, 1287' L.
 Drilling commenced May 24, 1908; completed June 26, 1908.
 No water recorded.
 10" casing, 255'; 8 $\frac{1}{2}$ ", 1473'; 6 $\frac{5}{8}$ ", 2260'; 5 $\frac{3}{8}$ ", 3020'; 2" tubing, 3150';
 all left in.
 Casing not cemented.
 Coal was encountered at 980-985'.
 Gas well. Record to Dept. of Mines dated May 16, 1951.
 Record to RCT from Mrs. Griffith Aug. 27, 1951. Old File No. 772.

	Top.	Bottom.
Pittsburgh Coal	980	- 985
Big Dunkard Sand	1443	- 1500
Gas Sand	1700	- 1775
Salt Sand	1819	- 1950
Little Lime	2215	- 2225
Big Lime	2280	- 2310
Big Injun Sand (gas, 2395')	2310	-
Fifty-foot Sand	2588	- 2599
Gordon Stray Sand (gas, 3052')	3017	- 3060
Gordon Sand (gas, 3074')	3061	- 3076
Fourth Sand	3094	- 3099
Total depth		3150