

Tract shown is the 195 ac. part of the Cumberlege tract conveyed to Urcel and Yonda Bond, by deed recorded in Deed Book No. 110, at page 194.

Surface owned by Urcel and Yonda Bond, whose postoffice address is Falsom, West Va. No coal

- New Location...
- Drill Deeper...
- Abandonment...

**FEB 18 1952**

Well purchased from South Penn Natural Gas Co. South Penn Map No. N-48

Company	<b>BROADWATER, WELCH AND TRAVIS</b>
Address	<b>West Union, W. Va.</b>
Farm	<b>H. C. Cumberlege</b>
Tract	Acres <b>220</b> Lease No. _____
Well (Farm) No.	<b>One</b> Serial No. _____
Elevation (Spirit Level)	<b>1262</b>
Quadrangle	<b>Centerpoint</b>
County	<b>Doddridge</b> District <b>McClellan</b>
Engineer	<i>W. H. J.</i>
Engineer's Registration No.	<b>1227</b>
File No.	_____ Drawing No. _____
Date	<b>March, 1951</b> Scale _____

**IVC**

STATE OF WEST VIRGINIA  
DEPARTMENT OF MINES  
OIL AND GAS DIVISION  
CHARLESTON

**WELL LOCATION MAP**  
FILE NO. **DOD-883-A**

+ Denotes location of well on United States Topographic Maps, scale 1 to 62,500, latitude and longitude lines being represented by border lines as shown.

- Denotes one inch spaces on border line of original tracing.

McClellan District, Deddridge County, W. Va.  
By Valley Steel Products Co., Box 8473, South Charleston, W. Va.  
Abandoned under permit Ded-.....-A?  
On.....acres.

Elevation, ..... L.

Drilling completed in 1896.

10" casing, 420'; 8 1/4" casing, 1399' (pulled); 6 5/8" casing, 2333'; 3 1/2" tubing, 1981'.

Shot Sept. 15, 1896, with 20 qts., top of shot, 2418'; July 14, 1900,

with 20 qts., top of shot, 2420'; Oct. 12, 1905, with 30 qts.,

top of shot, 2420'; Nov. 10, 1931, with 40 qts., top of shot, 2420'.

Plugging completed Sept. 20, 1951. 6 5/8" casing, pulled, 1602', lost, 721';

8 1/4" casing, pulled, 1085', lost, 314'; 10" casing, pulled, 418',

lost, 0'.

Oil well. Record to Dept. of Mines stamped July 23, 1951.

Record to RCT from Mrs. Griffith Nov. 28, 1951. Old File No. 775.

Pittsburgh Coal	Top. Bottom.
Gas, 2340'; oil, 2422'.	960 - ....
Total depth	2447



775

STATE OF WEST VIRGINIA  
DEPARTMENT OF MINES  
OIL AND GAS DIVISION

WELL RECORD

Permit No. 800-883-A

Oil or Gas Well X (KIND)


Company Valley Steel Products Company  
 Address P. O. Box 8473 - So. Charleston  
 Farm H. C. Cumberlandge Acres \_\_\_\_\_  
 Location (waters) \_\_\_\_\_  
 Well No. 1 Elev. 1262  
 District McClellan County Doddridge  
 The surface of tract is owned in fee by \_\_\_\_\_  
 Address \_\_\_\_\_  
 Mineral rights are owned by \_\_\_\_\_  
 Address \_\_\_\_\_  
 Drilling commenced \_\_\_\_\_  
 Drilling completed 1926  
 Date Shot \_\_\_\_\_ From \_\_\_\_\_ To \_\_\_\_\_  
 With \_\_\_\_\_  
 Open Flow \_\_\_\_\_ /10ths Water in \_\_\_\_\_ Inch  
 \_\_\_\_\_ /10ths Merc. in \_\_\_\_\_ Inch  
 Volume \_\_\_\_\_ Cu. Ft.  
 Rock Pressure \_\_\_\_\_ lbs. \_\_\_\_\_ hrs.  
 Oil \_\_\_\_\_ bbls., 1st 24 hrs.  
 Fresh water \_\_\_\_\_ feet \_\_\_\_\_ feet  
 Salt water \_\_\_\_\_ feet \_\_\_\_\_ feet

Casing and Tubing	Used in Drilling	Left in Well	Packers
Size			
16			Kind of Packer
13			
10	<u>420</u>	<u>420</u>	Size of
8 1/4	<u>1399</u>	<u>--</u>	
6 5/8	<u>2333</u>	<u>2333</u>	Depth set
5 3/16			
3 1/2	<u>1981</u>	<u>1981</u>	Perf. top
2			Perf. bottom
Liners Used			Perf. top
			Perf. bottom

CASING CEMENTED \_\_\_\_\_ SIZE \_\_\_\_\_ No. Ft. \_\_\_\_\_ Date \_\_\_\_\_

COAL WAS ENCOUNTERED AT \_\_\_\_\_ FEET \_\_\_\_\_ INCHES  
 \_\_\_\_\_ FEET \_\_\_\_\_ INCHES FEET \_\_\_\_\_ INCHES  
 \_\_\_\_\_ FEET \_\_\_\_\_ INCHES FEET \_\_\_\_\_ INCHES

Formation	Color	Hard or Soft	Top	Bottom	Oil, Gas or Water	Depth Found	Remarks
Pittsburgh Coal			960				
Gas	<u>shiny</u>		2340				
Oil	<u>black</u>		2422				
Total Depth				2447			
<b>Torpedo Record</b>							
Date shot		No. qts.		top of shot			
9/15/96		20	2418				
7/14/00		20	2420				
10/12/05		30	2420				
11/10/31		40	2420				
						1602'	721'
						1085'	314'
						418'	0'

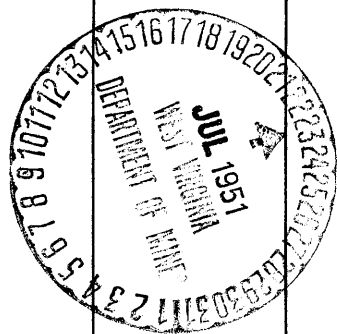

9-20-51