

FEB 18 1952

New Location
 Drill Deeper
 Abandonment

Company MURPHY OIL CO of PENNA.
 Address WEST UNION, W. VA.
 Farm W. L. ROLLINS
 Tract _____ Acres 75 Lease No. _____
 Well (Farm) No. 2, 5, 7 Serial No. _____
 Elevation (Spirit Level) 1180 - 993.7 - 896
 Quadrangle WEST UNION
 County DODDRIDGE District WEST UNION
 Engineer B. F. RINEHART
 Engineer's Registration No. 648
 File No. _____ Drawing No. 782-WD
 Date Sept. 21, 1950 Scale 1 in. = 400 ft.

STATE OF WEST VIRGINIA
 DEPARTMENT OF MINES
 OIL AND GAS DIVISION
 CHARLESTON

WELL LOCATION MAP
 FILE NO. D00-887-A-#7
D00-891-A-#2
D00-892-A-#5 way 017 7132

+ Denotes location of well on United States Topographic Maps, scale 1 to 62,500, latitude and longitude lines being represented by border lines as shown.

- Denotes one inch spaces on border line of original tracing.

(133)

W. L. ROLLINS MS. 7, 2, 8, 5 - MURPHY OIL Co, OF PA, - D00-887-A (#7) - D00-891-892-A



STATE OF WEST VIRGINIA
DEPARTMENT OF MINES
OIL AND GAS DIVISION

779

WELL RECORD

Permit No. 900-882 A


Oil or Gas Well Oil & Gas
(KIND)

Company Murphy Oil Company of Penna.
Address West Union, West Virginia.
Farm W.L. Rollins Acres 75
Location (waters) Arnolds Creek
Well No. 7 Elev. 896
District West Union County Doddridge
The surface of tract is owned in fee by W.L. Rollins
West Union, West Va address
Mineral rights are owned by W.L. Rollins
West Union, West Va address
Drilling commenced 1926
Drilling completed 1926
Date Shot _____ From _____ To _____
With 20 Qts.
Open Flow _____ /10ths Water in _____ Inch
_____ /10ths Merc. in _____ Inch
Volume _____ Cu. Ft.
Rock Pressure _____ lbs. _____ hrs.
Oil _____ bbls., 1st 24 hrs.
Fresh water _____ feet _____ feet
Salt water _____ feet _____ feet

Casing and Tubing	Used in Drilling	Left in Well	Packers
Size			Kind of Packer
16			
13			
10	400'	Pulled	Size of
8 1/4	867	867	
6 5/8	1723'-6"	1723'-6"	Depth set
5 3/16			
3			Perf. top
2	1804'	Pulled	Perf. bottom
Liners Used			Perf. top
			Perf. bottom

CASING CEMENTED _____ SIZE _____ No. Ft. _____ Date _____
COAL WAS ENCOUNTERED AT 393-397 FEET _____ INCHES
_____ FEET _____ INCHES FEET _____ INCHES
_____ FEET _____ INCHES FEET _____ INCHES

Formation	Color	Hard or Soft	Top	Bottom	Oil, Gas or Water	Depth Found	Remarks
Murry up Sand			210	262			
Pittsburgh Coal			393	397			
Little Dunkard			790	820			
Big Dunkard			860	890			
Gas Sand			931	960			
Sand			1020	1032			
1 st. Salt Sand			1045	1120			
2 nd. Salt Sand			1120	1232			
3 rd. Salt Sand			1302	1366			
Sand			1375	1430			
Naxon sand			1555				
Hole Reduced			1560				
Steel Line measurements							
showing of oil			1575	1580			
Little Lime			1690	1704			
pencil Cave			1704	1714			
Big Lime			1714	1782			
Big Injun			1782				
Gas			1783	1787	Gas		
Oil			1786	1801	Oil		
Total Depth.				1804			

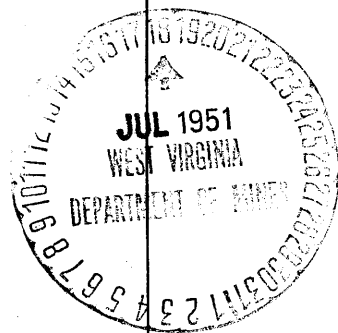

West Union District, Doddridge County, W. Va.
 By Murphy Oil Co. of Pa., West Union, W. Va.
 Abandoned under permit Dod-.....-A1
 On 75 acres, on Arnold Creek.

Elevation, 896' L.

Surface and minerals owned by W. L. Rollins, West Union, W. Va.

Drilling commenced and completed in 1926.

Shot with 20 qts.

10" casing, 400' (pulled); 8 1/4", 867'; 6 5/8", 1723 1/2'; 2" tubing, 1804' (pulled)

Coal was encountered at 393-397'.

Plugging completed Sept. 28, 1951. 6 5/8" casing, pulled, 1375', lost, 348';

8 1/4" casing, pulled, 867', lost, 0'.

Oil and gas well. Record to Dept. of Mines dated July 17, 1951.

Record to RCT from Mrs. Griffith Nov. 28, 1951. Old File No. 779.

	Top.	Bottom.
Hurry-up Sand	210	- 262
Pittsburgh Coal	393	- 397
Little Dunkard Sand	790	- 820
Big Dunkard Sand	860	- 890
Gas Sand	931	- 960
Sand	1020	- 1032
1st Salt Sand	1045	- 1120
2nd Salt Sand	1120	- 1232
3rd Salt Sand	1302	- 1366
Sand	1375	- 1430
Marton Sand	1555	-
(Hole reduced at 1560') (SLM)		
(showing of oil, 1575-1580')		
Little Lime	1690	- 1704
Pencil Cave	1704	- 1714
Big Lime	1714	- 1782
Big Injun Sand (gas, 1783-1737'; oil, 1786-1801')	1782	-
Total depth		1804