

0.33 W
1282

Coal and surface owned by Glenn & Sibyl Cunningham, of Route No. 1, West Union, West Va., by virtue of deed from Etta Cunningham, dated Sept. 21, 1949, and recorded in the Office of the County Clerk of Doddridge County, in Deed Book 114 at page 199.

New Location...
 Drill Deeper...
 Abandonment...

FEB 18 1952

Company **VALLEY STEEL PRODUCTS CO.**
 Address **St. Louis, Mo.**
 Farm **M. J. Hudkins**
 Tract _____ Acres **65.06** Lease No. _____
 Well (Farm) No. **One** Serial No. _____
 Elevation (Spirit Level) **1025**
 Quadrangle **Holbrook**
 County **Doddridge** District **Central**
 Engineer *W. H. Hart*
 Engineer's Registration No. **1227**
 File No. _____ Drawing No. _____
 Date **August, 1951** Scale **1" = 500'**

STATE OF WEST VIRGINIA
 DEPARTMENT OF MINES
 OIL AND GAS DIVISION
 CHARLESTON

WELL LOCATION MAP
 FILE NO. **DOD-890-A**

⊕ Denotes location of well on United States Topographic Maps, scale 1 to 62,500, latitude and longitude lines being represented by border lines as shown.
 — Denotes one inch spaces on border line of original tracing.

Central District, Doddridge County, W. Va.
 By Valley Steel Products Co., St. Louis, Mo.
 Abandoned under permit Dod-.....-A?
 On 65 acres, on Cabin Run.
 Elevation, 1025' L.
 Date of completion, etc., not given.
 5³/₁₆" casing, 1929'; 2" tubing, 2025'; all left in.
 Gas well. Record to Dept. of Mines stamped Aug. 7, 1951.
 Record to RCT from Mrs. Griffith Feb. 29, 1952. Old File No. 844.

	Top. Bottom.
Big Lime	1929 - 2000
Keener Sand (gas, 2000-2008')	2000 - 2025



STATE OF WEST VIRGINIA
DEPARTMENT OF MINES
OIL AND GAS DIVISION

844

Permit No. 860-890-A

Oil or Gas Well _____
(KIND)


Company VALLEY STEEL PRODUCTS COMPANY
Address ST. LOUIS, MO.
Farm M. J. HUDKINS Acres 65
Location (waters) CABIN RUN
Well No. 1 Elev. 1025.1
District Central County Doddridge
The surface of tract is owned in fee by _____
Address _____
Mineral rights are owned by _____
Address _____
Drilling commenced _____
Drilling completed _____
Date Shot _____ From _____ To _____
With _____
Open Flow _____ /10ths Water in _____ Inch
_____ /10ths Merc. in _____ Inch
Volume _____ Cu. Ft.
Rock Pressure _____ lbs. _____ hrs.
Oil _____ bbls., 1st 24 hrs.
Fresh water _____ feet _____ feet
Salt water _____ feet _____ feet

Casing and Tubing	Used in Drilling	Left in Well	Packers
Size			Kind of Packer
16			
13			
10			Size of
8 1/4			
6 5/8	1929	1929	Depth set
5 3/16			
3			Perf. top
2	2025	2025	Perf. bottom
Liners Used			Perf. top
			Perf. bottom

CASING CEMENTED _____ SIZE _____ No. Ft. _____ Date _____

COAL WAS ENCOUNTERED AT _____ FEET _____ INCHES
_____ FEET _____ INCHES _____ FEET _____ INCHES
_____ FEET _____ INCHES _____ FEET _____ INCHES

Formation	Color	Hard or Soft	Top	Bottom	Oil, Gas or Water	Depth Found	Remarks
Big Line			1929	2000'			
Keener			2000				
Total Depth				2025			Gas 2000' - 2005'

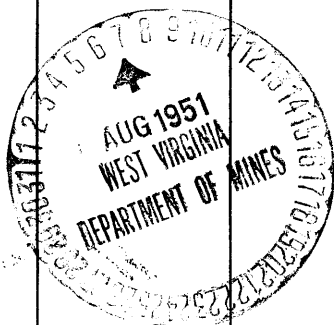

(Over)
FEB 29 1952