

Company MURPHY OIL CO of PENNA.
 Address WEST UNION, W. VA.
 Farm W. L. ROLLINS
 Tract _____ Acres 75 Lease No. _____
 Well (Farm) No. 2, 5, 7 Serial No. _____
 Elevation (Spirit Level) 1180 - 993.7 - 896
 Quadrangle WEST UNION
 County DODDRIDGE District WEST UNION
 Engineer B. F. RINEHART
 Engineer's Registration No. 648
 File No. _____ Drawing No. 782-WD
 Date Sept. 21, 1950 Scale 1 in. = 400 ft.

STATE OF WEST VIRGINIA
 DEPARTMENT OF MINES
 OIL AND GAS DIVISION
 CHARLESTON

WELL LOCATION MAP
 DOO-887-A-#7
 FILE NO. ~~DOO-891-A-#2~~
~~DOO-892-A-#5~~

+ Denotes location of well on United States Topographic Maps, scale 1 to 62,500, latitude and longitude lines being represented by border lines as shown.

- Denotes one inch spaces on border line of original tracing.

"IMPERIAL" TRACING CLOTH
 K & F CO., N. Y.

W.L. ROLLINS MS. 7, 2, 2, 5 - MURPHY OIL CO. OF PA. - DOO-887-A (#7)
 ID-891-892-A



STATE OF WEST VIRGINIA
DEPARTMENT OF MINES
OIL AND GAS DIVISION

786

WELL RECORD

Permit No. 800-891-A

Oil or Gas Well Oil & Gas
(KIND)


Company Murphy Oil Company of Penna.
 Address West Union, West Virginia
 Farm W.L. Rollins Acres 75
 Location (waters) Arnolds Creek
 Well No. 2 Elev. 1170
 District West Union County Doddridge
 The surface of tract is owned in fee by W.L. Rollins Address West Union, W.Va.
 Mineral rights are owned by W.L. Rollins Address West Union, W.Va.
 Drilling commenced _____
 Drilling completed _____
 Date Shot _____ From _____ To _____
 With _____
 Open Flow _____ /10ths Water in _____ Inch
 _____ /10ths Merc. in _____ Inch
 Volume _____ Cu. Ft.
 Rock Pressure _____ lbs. _____ hrs.
 Oil _____ bbls., 1st 24 hrs.
 Fresh water _____ feet _____ feet
 Salt water _____ feet _____ feet

Casing and Tubing	Used in Drilling	Left in Well	Packers
Size			
16			Kind of Packer
13			
10	590'	None	Size of
8 1/4	1207'	1100'	
6 1/2	2047'	2047'	Depth set
5 3/16			
3			Perf. top
2	2195'	2195'	Perf. bottom
Liners Used			Perf. top
			Perf. bottom

CASING CEMENTED _____ SIZE _____ No. Ft. _____ Date _____

COAL WAS ENCOUNTERED AT 700 FEET _____ INCHES
 _____ FEET _____ INCHES _____ FEET _____ INCHES
 _____ FEET _____ INCHES _____ FEET _____ INCHES

Formation	Color	Hard or Soft	Top	Bottom	Oil, Gas or Water	Depth Found	Remarks
Pittsburg Coal			700'	702'			
Little Dunkard			1085	1095			
Big Dunkard			1197	1224			
Gas Sand			1320	1350			
1st. Salt Sand			1390	1411			
2nd. Salt Sand			1495	1538			
Maxon			1873	1908			
Little Lime			1892	1906			
Pencil Cave			1906	1911			
Big Injnn			2096	2181			
Gas 2163			2163				
Total Depth.			2201				
						11-12-51	
						2179	0'
						1125'	923'

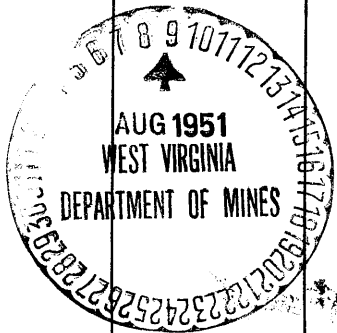

JAN 16 1952

