

| | |
|-----|--------|
| # 1 | 2.32 W |
| | 1.51 Q |
| # 2 | 2.28 W |
| | 1.53 Q |

New Location
 Drill Deeper
 Abandonment

FFR 18 1952

Company JAMES R. KOOKEN
 Address PENNSBORO, W. VA.
 Farm LEROY INGRAM
 Tract _____ Acres 65 Lease No. _____
 Well (Farm) No. 1 & 2 Serial No. _____
 Elevation (Spirit Level) 866.6 - 861
 Quadrangle HOLBROOK
 County DODDRIDGE District CENTRAL
 Engineer B. F. RINEHART
 Engineer's Registration No. 648
 File No. _____ Drawing No. 890-CD
 Date Nov. 17, 1951 Scale 1 in. = 400 ft.

STATE OF WEST VIRGINIA
 DEPARTMENT OF MINES
 OIL AND GAS DIVISION
 CHARLESTON

WELL LOCATION MAP

FILE NO. DOD-910-A-#1
DOD-911-A-#2

+ Denotes location of well on United States Topographic Maps, scale 1 to 62,500, latitude and longitude lines being represented by border lines as shown.

- Denotes one inch spaces on border line of original tracing.

LEROY INGRAM TRS. 1&2 - JAMES R. KOOKEN - DOD-910-911-A



STATE OF WEST VIRGINIA
DEPARTMENT OF MINES
OIL AND GAS DIVISION

859

WELL RECORD

Permit No. 910-A

Oil or Gas Well Oil

(KIND)

Company J. R. Kooker
Address Pennshoro, W. Va.
Farm Leroy Ingram Acres 65
Location (waters) Cabin Run
Well No. 1 Elev. 866.6
District Central County Dodderidge
The surface of tract is owned in fee by Leroy Ingram
Address East Union, W. Va.
Mineral rights are owned by G. S. Banstreet
Address Pennshoro, W. Va.

Drilling commenced _____
Drilling completed 1925
Date Shot _____ From _____ To _____
With _____

Open Flow _____ /10ths Water in _____ Inch
_____ /10ths Merc. in _____ Inch

Volume _____ Cu. Ft.

Rock Pressure _____ lbs. _____ hrs.

Oil _____ bbls., 1st 24 hrs.

Fresh water _____ feet _____ feet

Salt water _____ feet _____ feet

| Casing and Tubing | Used in Drilling | Left in Well | Packers |
|-------------------|------------------|--------------|----------------|
| Size | | | |
| 16 | | | Kind of Packer |
| 13 | | | |
| 10 | | | Size of |
| 8 1/2 | | | |
| 6 | | | Depth set |
| 5 3/16 | 1813 | 1813 | |
| 3 | | | Perf. top |
| 2 | 1975 | 1975 | Perf. bottom |
| Liners Used | | | Perf. top |
| | | | Perf. bottom |

CASING CEMENTED _____ SIZE _____ No. Ft. _____ Date _____


COAL WAS ENCOUNTERED AT _____ FEET _____ INCHES

_____ FEET _____ INCHES _____ FEET _____ INCHES

_____ FEET _____ INCHES _____ FEET _____ INCHES

| Formation | Color | Hard or Soft | Top | Bottom | Oil, Gas or Water | Depth Found | Remarks |
|-------------|-------|--------------|------|-----------|-------------------|-------------|---------|
| Big Dunbar | | | 1080 | 1132 | | | |
| Soft Sand | | | 1325 | ? | | | |
| Wagon Sand | | | 1780 | 1825 | | | |
| Little Line | | | 1824 | 1840 | | | |
| Pencil Cave | | | 1842 | 1846 | | | |
| Big Line | | | 1846 | 1933 | | | |
| Big Injun | | | 1933 | 1975 - TD | | | |

Handwritten circled 'C' and 'O.F. 841' in the table area.

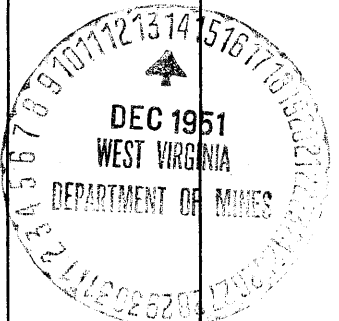

MAY 21 1952 (Over)

| Formation | Color | Hard or Soft | Top | Bottom | Oil, Gas or Water | Depth Found | Remarks |
|-----------|-------|--------------|-----|--------|-------------------|-------------|---------|
| | | | | | | | |

Date Dec 12, 1951

APPROVED J.P. Wood, Owner

By Self (Title)