

New Location
 Drill Deeper
 Abandonment

FFR 18 1952

# 1	2.32 W
	1.51 Q
# 2	2.28 W
	1.53 Q

Company JAMES R. KOOKEN
 Address PENNSBORO, W. VA.
 Farm LEROY INGRAM
 Tract _____ Acres 65 Lease No. _____
 Well (Farm) No. 1 & 2 Serial No. _____
 Elevation (Spirit Level) 866.6 - 861
 Quadrangle HOLBROOK
 County DODDRIDGE District CENTRAL
 Engineer B. F. RINEHART
 Engineer's Registration No. 648
 File No. _____ Drawing No. 890-CD
 Date Nov. 17, 1951 Scale 1 in. = 400 ft.

STATE OF WEST VIRGINIA
 DEPARTMENT OF MINES
 OIL AND GAS DIVISION
 CHARLESTON

WELL LOCATION MAP

FILE NO. DOD-910-A-#1
DOD-911-A-#2

+ Denotes location of well on United States Topographic Maps, scale 1 to 62,500, latitude and longitude lines being represented by border lines as shown.

- Denotes one inch spaces on border line of original tracing.

LEROY INGRAM TRS. 1&2 - JAMES R. KOOKEN - DOD.910-911-A



845

STATE OF WEST VIRGINIA
DEPARTMENT OF MINES
OIL AND GAS DIVISION

WELL RECORD

Permit No. 060-911-A


Oil or Gas Well Oil

Company J. R. Kooken
 Address Pennsboro, W. Va.
 Farm Leroy Ingram Acres 65
 Location (waters) Cabin Run
 Well No. 2 Elev. 861'
 District Central County Doddridge
 The surface of tract is owned in fee by Leroy Ingram
 Address West Union, W. Va.
 Mineral rights are owned by D. S. Lanstreet
 Address Pennsboro, W. Va.
 Drilling commenced _____
 Drilling completed 1958
 Date Shot From _____ To _____
 With _____
 Open Flow _____ /10ths Water in _____ Inch
 _____ /10ths Merc. in _____ Inch
 Volume _____ Cu. Ft.
 Rock Pressure _____ lbs. _____ hrs.
 Oil _____ bbls., 1st 24 hrs.
 Fresh water _____ feet _____ feet
 Salt water _____ feet _____ feet

Casing and Tubing	Used in Drilling	Left in Well	Packers
Size			
16			Kind of Packer
13			
10			Size of
8 1/4			
6 1/2			Depth set
5 3/16	<u>1861</u>	<u>1861</u>	
3			Perf. top
2	<u>1958</u>	<u>1958</u>	Perf. bottom
Liners Used			Perf. top
			Perf. bottom

CASING CEMENTED _____ SIZE _____ No. Ft. _____ Date _____
 COAL WAS ENCOUNTERED AT _____ FEET _____ INCHES
 _____ FEET _____ INCHES _____ FEET _____ INCHES
 _____ FEET _____ INCHES _____ FEET _____ INCHES

Formation	Color	Hard or Soft	Top	Bottom	Oil, Gas or Water	Depth Found	Remarks
Big Duncard			1068	1113			
Salt Sand			1305	?			
Maxon Sand			1763	1800			
Pencil Cove			1822	1826			
Big Line			1824	1911			
Big Injan			1911	1958			
				<u>1958 TD</u>			

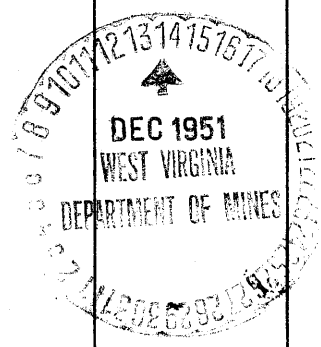

FEB 29 1952

Formation	Color	Hard or Soft	Top	Bottom	Oil, Gas or Water	Depth Found	Remarks

Date Dec 12, 1951

APPROVED JR. [Signature], Owner

By Self (Title)

911A
LEROY INGRAM NO. 2 WELL.

Central District, Doddridge County, W. Va.

By J. R. Kecken, Pennsboro, W. Va.

Abandoned under permit Dod-.....-A?

On 65 acres, on Cabin Run.

Elevation, 861' L.

Surface owned by Leroy Ingram, West Union, W. Va., and minerals by
G. S. Wanstreet, Pennsboro, W. Va.

Drilling completed in 1926.

5³/₁₆" casing, 1861'; 2" tubing, 1958'; all left in.

Oil well. Record to Dept. of Mines dated Dec. 12, 1951.

Record to RCT from Mrs. Griffith Feb. 29, 1952. Old File No. 845.

	Top.	Bottom.
Big Dunkard Sand	1068	- 1118
Salt Sand	1305	-?
Maxton Sand	1768	- 1800
Pencil Cave	1822	- 1826?
Big Lime	1824?	- 1911
Big Injun Sand	1911	- 1958
Total depth		1958