

Latitude 39°25'00"

11,00,04,08

Longitude

75'
+

Topo Location

7.5' Loc.	<u>1.245</u>	15' Loc.	<u>1.245</u>
	<u>1.35W</u>	(calc.)	<u>1.35W</u>

Company _____

Farm Nancy Underwood #7

15' Quad Antisport WC
(sec.)

7.5' Quad Center Point

District McClellan

WELL LOCATION PLAT

County 017 Permit 30916

WELL RECORD

Oil or Gas Well _____

Permit No. _____

Company WURTZ BROS
 Address Highgate
 Farm under Underwood Acres _____
 Location (quarters) _____
 Well No. 7 Elev. _____
 District W. Va. County Putnam
 The surface of land is owned in fee by _____
 Address _____
 Mineral rights are owned by _____
 Address _____
 Drilling commenced _____
 Drilling completed Apr. 1926
 Date shut in From _____ To _____
 Well _____
 Open Flow _____ Inch _____
 _____ Inch _____
 Volume _____ Cu. Ft. _____
 Shut Pressure _____ lbs. _____
 Oil _____ bbls. in 24 hrs. _____
 Fresh water _____ feet _____
 Salt water _____ feet _____

Casing and Tubing	Used in Drilling	Left in Well	Packers
16			Kind of Packer _____
13			Size of _____
10			Depth set _____
8 1/2		1960	Perf. top _____
6 1/2			Perf. bottom _____
5 3/16			Perf. top _____
3			Perf. bottom _____
2			Perf. top _____
			Perf. bottom _____


Liners Used _____

CASING CEMENTED _____ SIZE _____ No. Ft. _____

COAL WAS ENCOUNTERED AT 493 FEET 12" DOWN

FEET	INCHES	FEET	DOWN
_____	_____	_____	_____
_____	_____	_____	_____

Formation	Top	Hard or Soft	Top	Bottom	Oil, Gas or Water	Depth Found	Remarks
1914	493		493	493			
1914	1914		1914	1610			
1914	1914		1914	1730			
1914	1914		1914	1820	12 1/4	1940	
1914	1914		1914	1959			

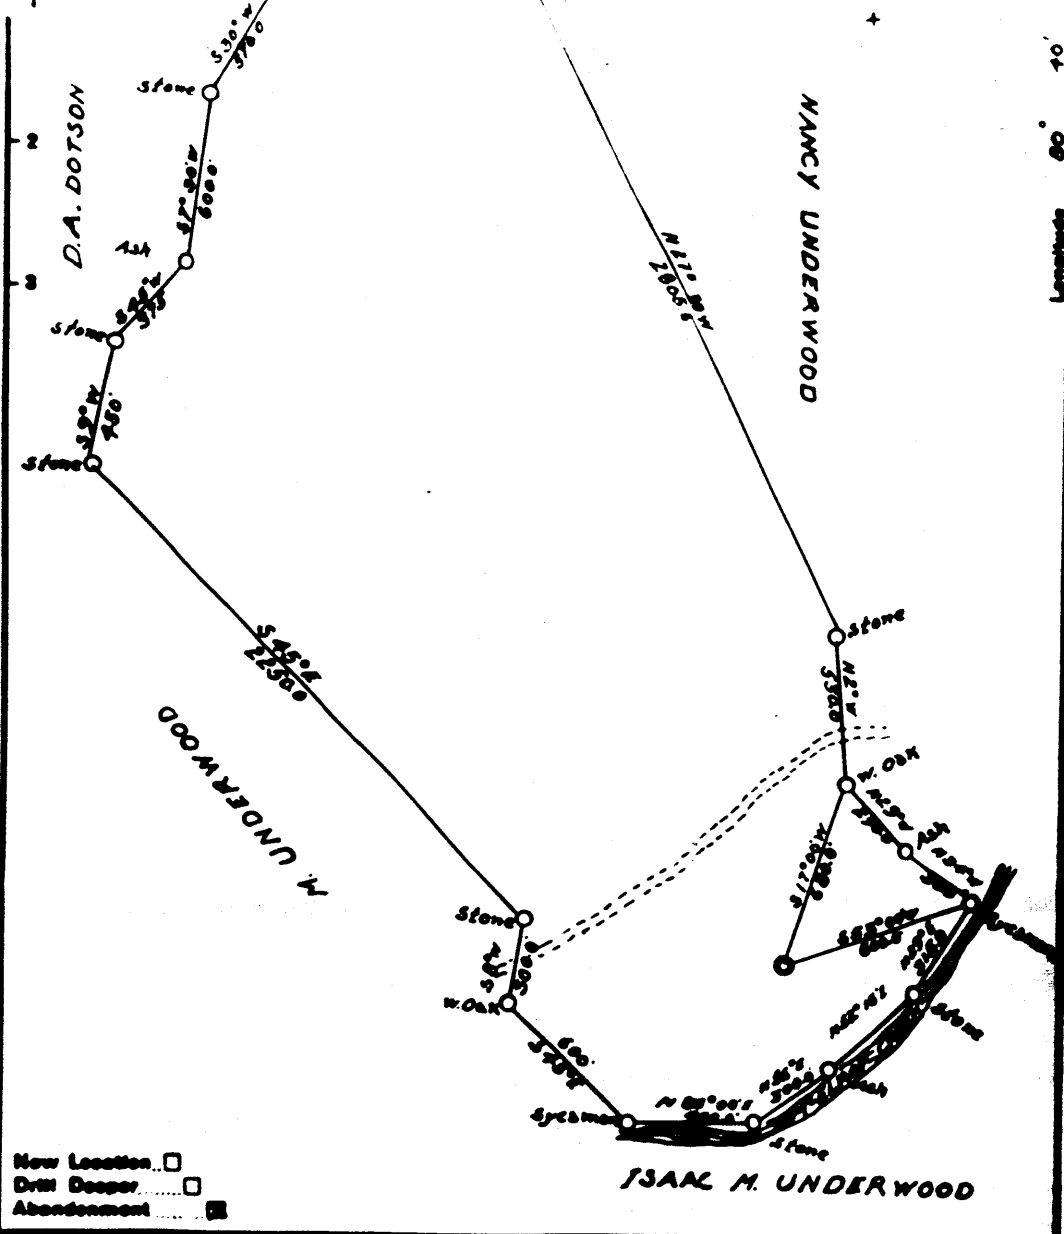

New Location
 Drien Deeper
 Abandonment

Company WURTZ BROTHERS
 Address PITTSBURGH PA
 Farm 2000 UNDERWOOD
 Tract ONE Acres 461 Lease No. _____
 Well (Farm) No. 7 Serial No. _____
 Elevation (Spirit Level) 755
 Quadrangle CENTERPOINT
 County DODD RIDGE District MCLELLAN

STATE OF WEST VIRGINIA
 DEPARTMENT OF MINES
 OIL AND GAS DIVISION
 CHARLESTON

WELL LOCATION MAP
 FILE NO. 000-916-2

◆ Denotes location of well on United States Topographic Maps, scale 1 to 62,500. Int.

DEPARTMENT OF MINES
OIL AND GAS DIVISION

NOTICE OF INTENTION TO PLUG AND ABANDON WELL

REQUIRED BY SECTION 10, ARTICLE 4, CHAPTER 22 OF THE CODE

To The Department of Mines
Charleston, W. Va.

Coal Operator or Coal Owner

Name of Well Operator
J. B. Hall

Address

1000 S. 10th St., Ashby, W. Va.
Complete Address

Coal Operator or Coal Owner

1000 S. 10th St., Ashby, W. Va. 19 52

Address

McClellan District

Lease or Property Owner

Mad ridge County

Address

Well No. 7 39° 25' 80° 40'
Zedoc Underwood Farm

Gentlemen:—

**NOTIFY INSPECTOR MANKY V. MAZUR - DISTRICT, W. VA.
24 HOURS IN ADVANCE OF PLUGGING.**

The undersigned well operator is about to abandon the above described well and will commence

the work of plugging and abandoning said well on the _____ day of _____, 19 _____,
(which date shall not be less than five days after the day on which this notice so mailed is received,
or in due course should be received by the Department of Mines.)

This notice is given you in order that your respective representatives may be present at the plugging and filling of said well. You are further notified that whether you are represented or not represented the undersigned will proceed on that date, or shortly thereafter, to plug and fill said well in the manner required by Section 10, Article 4, Chapter 22 of the Code and given in detail on the reverse side of this notice, in "Work Order."

This notice is being mailed by registered mail to each of you at the above addresses on the above date.

Very truly yours,

J. B. Hall
Well Operator.



NOTE: Upon application for a permit to plug and abandon any well drilled prior to June 1, 1929, a plat prepared by a competent engineer, showing the district and county in which the tract of land is located, the name and acreage of same, the names of the owners and adjacent tracts, and the location of the about to be abandoned well, determined by survey, and the compass and distance of such well from two permanent points or landmarks on said tract shall be submitted with the application.

WEST VIRGINIA DEPARTMENT OF MINES
OIL AND GAS DIVISION
WORK ORDER

Well to be plugged and filled as follows

Clay 1950 to 1800

Cement 1800 to 1790

Clay 1790 1700

Cement 1700 1690.

Bridge 1630 to 1620.

Clay 1620 to 1500

Cement 1500 to 1490

Bridge. 1000 to 980

Clay 980 to 900

Cement 700 to 690.

Bridge 535 to 525

Clay 525 to 515

Dist. Inspector, according to

To the Department of Mines
Coal Owner or Operator,
Lease or Property Owner.

Gentlemen:

This "work order" is submitted for your approval and disapproval or non-concurrence, the undersigned will proceed to plug and fill said well in the above described manner on the date stated above. I do not intend to abandon the said well on opposite side of this sheet.

Very truly yours,

No objections have been filed by the coal owner or property owners or interposed by the Department of Mines to the plugging and filling of the well above mentioned.

1st day of February, 1952 19