

Latitude 39°25'00"

1100.0408

Longitude  
15'  
+

Topo Location

7.5' Loc. 2.00S 15' Loc. 2.00S  
0.15W (calc.) 0.15W

Company \_\_\_\_\_

Farm D. Ash


15' Quad Centerpoint WC  
(sec.)

7.5' Quad Center Point

District McClellan

WELL LOCATION PLAT

County 017 Permit 30932

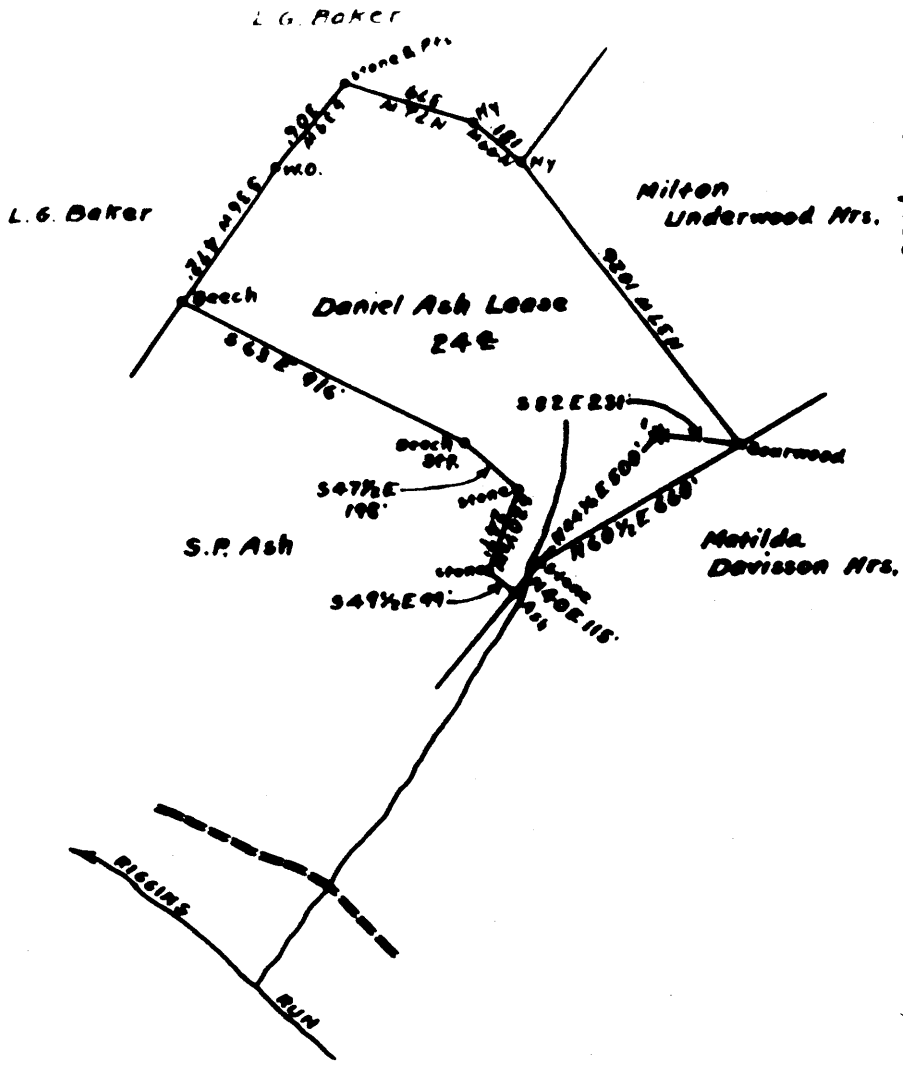

Surface & Coal owned by Daniel Ash Mrs.  
 Address: Mrs. Florence Drummond, Lumberport, W. Va.

Now Location   
 Drill Deeper

Abandonment  ON 800' Map N38. Sec. S4-5 E 2-3.

Company Read Supply Co.  
 Address Salem, W. Va.  
 Form Daniel Ash  
 Tract Acres 24 Lease No. \_\_\_\_\_  
 Well (Form) No. 1 Serial No. \_\_\_\_\_

STATE OF WEST VIRGINIA  
 DEPARTMENT OF MINES  
 OIL AND GAS DIVISION  
 CHARLESTON

WELL LOCATION MAP

DANIEL ASH NO. 1 WELL.

932A

McClellan District, Doddridge County, W. Va.  
By Head Supply Co., 184 E. Main St., Salem, W. Va.  
Abandoned under permit No. ....-A7  
On.....screws, on Higgins Run.  
Elevation, .....<sup>+</sup> L.  
Drilling commenced Aug. 17, 1925; completed Oct. 14, 1925.  
6<sup>5</sup>/<sub>8</sub>" casing, 2114'; 2" tubing, 2950'.  
Casing not cemented.  
Coal was encountered at 756-760'.  
Gas well. Record to Dept. of Mines dated Aug. 28, 1952.  
Record to RCF from Mrs. Griffith Dec. 10, 1952. C.F.No.877.

	Top.	Bottom.
Pittsburgh Coal	756	- 760
Big Dunkard Sand	1290	- 1310
Gas Sand	1360	- 1390
Big Injun Sand	2022	- 2114
Stray Sand	2842	- 2858
Gordon Sand (gas, 2863-2867')	2860	- 2870
Fifth Sand	2995	- 3001
Total depth		3007



STATE OF WEST VIRGINIA  
DEPARTMENT OF MINES  
OIL AND GAS DIVISION

877

Permit No. 900-932-A

WELL RECORD

Oil or Gas Well

Company Read Supply Company  
 Address 184 East Main St., Sales, W. Va.  
 Farm Daniel Ash Acres \_\_\_\_\_  
 Location (waters) Riggins Run  
 Well No. 1 Elev. \_\_\_\_\_  
 District McClelland County Doddridge  
 The surface of tract is owned in fee by \_\_\_\_\_  
 Address \_\_\_\_\_  
 Mineral rights are owned by \_\_\_\_\_  
 Address \_\_\_\_\_  
 Drilling commenced August 17, 1925  
 Drilling completed October 14, 1925  
 Date Shot From \_\_\_\_\_ To \_\_\_\_\_  
 With \_\_\_\_\_  
 Open Flow /10ths Water in \_\_\_\_\_ Inch  
 /10ths Merc. in \_\_\_\_\_ Inch  
 Volume \_\_\_\_\_ Cu. Ft.  
 Rock Pressure \_\_\_\_\_ lbs. \_\_\_\_\_ hrs.  
 Oil \_\_\_\_\_ bbls., 1st 24 hrs.  
 Fresh water \_\_\_\_\_ feet \_\_\_\_\_ feet  
 Salt water \_\_\_\_\_ feet \_\_\_\_\_ feet

Casing and Tubing	Used in Drilling	Left in Well	Packers
Size			
16			Kind of Packer
13			
10			Size of
8 1/4			
6 3/4	<b>2114'</b>	<b>2114'</b>	Depth set
5 3/16			
3			Perf. top
2	<b>2950'</b>	<b>2950'</b>	Perf. bottom
Liners Used			Perf. top
			Perf. bottom

CASING CEMENTED No SIZE \_\_\_\_\_ No. Ft. \_\_\_\_\_ Date \_\_\_\_\_

COAL WAS ENCOUNTERED AT 760 FEET 43 INCHES  
 \_\_\_\_\_ FEET \_\_\_\_\_ INCHES FEET \_\_\_\_\_ INCHES  
 \_\_\_\_\_ FEET \_\_\_\_\_ INCHES FEET \_\_\_\_\_ INCHES

Formation	Color	Hard or Soft	Top	Bottom	Oil, Gas or Water	Depth Found	Remarks
<b>Pittsburgh Coal</b>			<b>756</b>	<b>760</b>			
<b>Big Dunkard</b>			<b>1290</b>	<b>1310</b>			
<b>Gas Sand</b>			<b>1360</b>	<b>1390</b>			
<b>Big Injun</b>			<b>2022</b>	<b>2114</b>			
<b>Stray Sand</b>			<b>2842</b>	<b>2858</b>			
<b>Gordon Sand</b>			<b>2860</b>	<b>2870</b>			
<b>Gas</b>			<b>2863</b>	<b>2867</b>			
<b>Fifth Sand</b>			<b>2995</b>	<b>3001</b>			
<b>Total Depth</b>				<b>3007</b>			





