

Latitude 39°20' 00"

03' 24" 00"

75' +  
Longitude

Topo Location

7.5' Loc. 1.75S 15' Loc. 1.75S  
0.14W (calc.) 2.37W

Company \_\_\_\_\_

Farm C. C. Heflin


15' Quad Centiput SW  
(sec.)

7.5' Quad Smithburg

District West Union

WELL LOCATION PLAT

County 017 Permit 30933

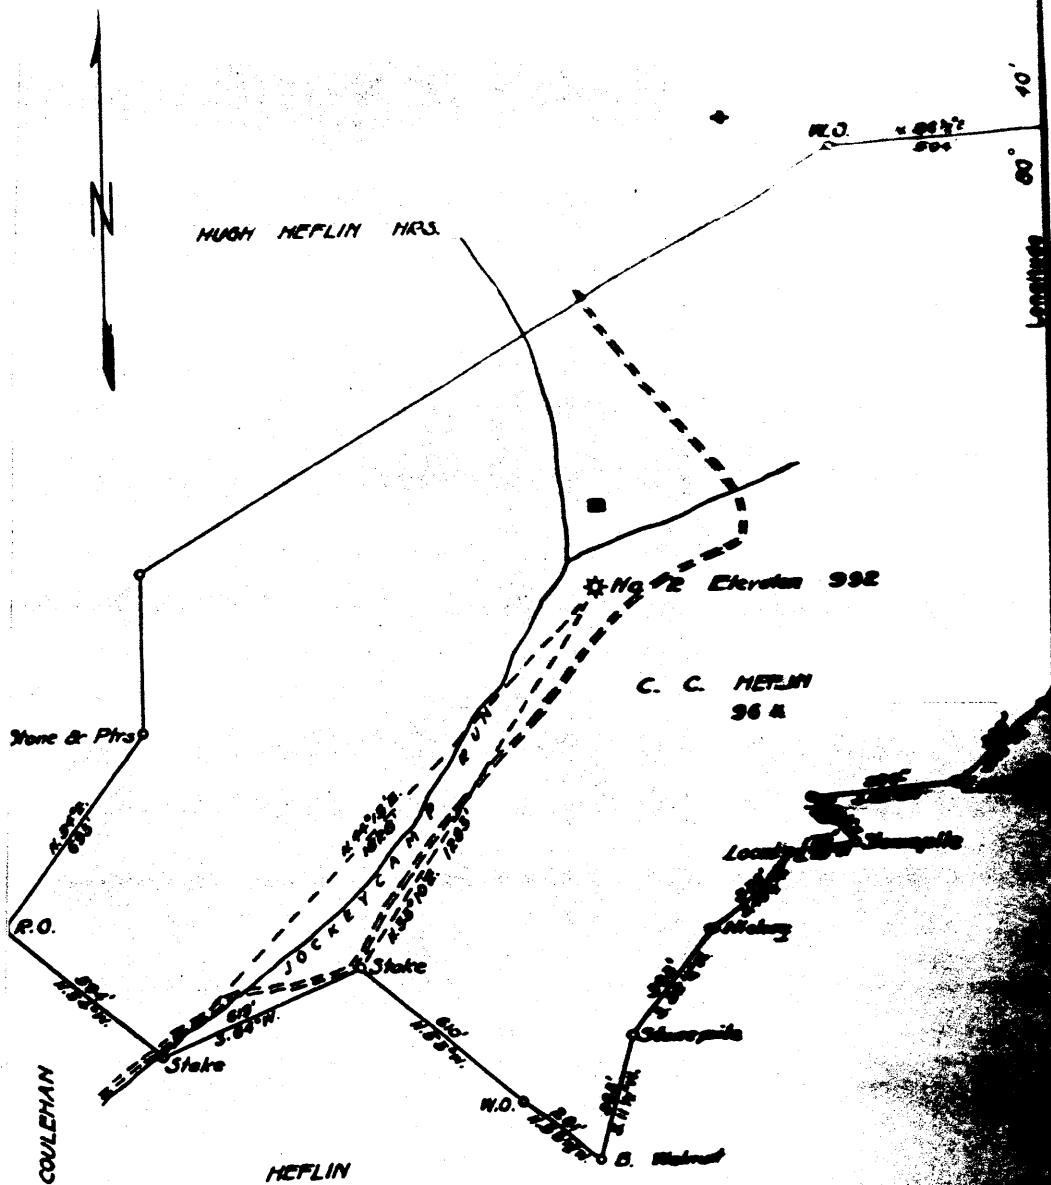

New Location   
 Drill Deeper   
 Abandonment

Company	JAMES P. KOOKEN		
Address	PENNSBORO, W. VA.		
Farm	C. C. HEFLIN		
Tract	Acres	96	Lease No.
Well (Farm) No.	2		Serial No.
Elevation (Spirit Level)	992		
	CENTROPOINT		

STATE OF WEST VIRGINIA  
 DEPARTMENT OF MINES  
 OIL AND GAS DIVISION  
 CHARLESTON

**WELL LOCATION MAP**  
 FILE NO. 000-992

C. C. HEFLIN NO. 2 WELL.

933A

West Union District, Doddridge County, W. Va.

By J. R. Keoken, Pennsboro, W. Va.

Abandoned under permit No. ....-4?

On 96 acres, on Jeckycamp Mtn.

Elevation, 992' L.

Surface owned by C. C. Heflin, Morgansville, W. Va., and minerals by

J. P. Breppleman and J. D. Foley, West Union, W. Va.

Drilling completed in 1908.

6 1/2" casing, 1768'; 5", 800'; all left in; top of hole? hook-well packer.

One well. Record to Dept. of Mines dated Sept. 20, 1952.

Record to EOP from Mrs. Griffith Dec. 10, 1952. O.F.No. 883.

	Top.	Bottom.
Red rock	565	- 980
Cow Run Sand	980	- 1000
1st Salt Sand	1150	- 1200
2nd Salt Sand	1220	- 1315
3rd Salt Sand	1400	- 1525
Horton Sand	1690	- 1710
Little Line	1710	- 1870
Big Line	1895	- 1947
Big Injun Sand	1947	- 2048
Total depth		2048



883

STATE OF WEST VIRGINIA  
DEPARTMENT OF MINES  
OIL AND GAS DIVISION

WELL RECORD

Permit No. 080-933-A

Oil or Gas Well Gas  
(KIND)

Company J. R. Kooken  
 Address Pennsboro, W. Va.  
 Farm C. C. Heflin Acres 96  
 Location (waters) Jockey Camp Run  
 Well No. 2 Elev. 992  
 District West Union County Doddridge  
 The surface of tract is owned in fee by C. C. Heflin  
 Address Loppsville, W. Va.  
 Mineral rights are owned by J. R. Brogdon, J. D.  
Moley Address West Union  
 Drilling commenced \_\_\_\_\_  
 Drilling completed 1908  
 Date Shot \_\_\_\_\_ From \_\_\_\_\_ To \_\_\_\_\_  
 With \_\_\_\_\_  
 Open Flow \_\_\_\_\_ /10ths Water in \_\_\_\_\_ Inch  
 \_\_\_\_\_ /10ths Merc. in \_\_\_\_\_ Inch  
 Volume \_\_\_\_\_ Cu. Ft.  
 Rock Pressure \_\_\_\_\_ lbs. \_\_\_\_\_ hrs.  
 Oil \_\_\_\_\_ bbls., 1st 24 hrs.  
 Fresh water \_\_\_\_\_ feet  
 Salt water \_\_\_\_\_ feet

Casing and Tubing	Used in Drilling	Left in Well	Packers
Size			
16			Kind of Packer
13			
10			Size of
8 1/4			
6 5/8	<u>1768</u>	<u>1768</u>	Depth set
5 3/16	<u>( 800</u>	<u>800</u>	
3	<u>(Top of hole - Hook</u>		Perf. top
2	<u>well packer)</u>		Perf. bottom
Liners Used			Perf. top
			Perf. bottom

CASING CEMENTED \_\_\_\_\_ SIZE \_\_\_\_\_ No. Ft. \_\_\_\_\_ Date \_\_\_\_\_  
 COAL WAS ENCOUNTERED AT \_\_\_\_\_ FEET \_\_\_\_\_ INCHES  
 \_\_\_\_\_ FEET \_\_\_\_\_ INCHES FEET \_\_\_\_\_ INCHES  
 \_\_\_\_\_ FEET \_\_\_\_\_ INCHES FEET \_\_\_\_\_ INCHES

Formation	Color	Hard or Soft	Top	Bottom	Oil, Gas or Water	Depth Found	Remarks
Red Rock			565	980			
Low Run			980	1000			
1st Salt Sand			1150	1200			
2nd Salt Sand			1220	1315			
3rd Salt Sand			1400	1525			
Maxon Sand			1690	1710			
Little Lime			1710	1870			
Big Lime			1895	1947			
Big Injun			1947	2048			
Total Depth				2048			



DEC 10 1952

Formation	Color	Hard or Soft	Top	Bottom	Oil, Gas or Water	Depth Found	Remarks

Date Sept 20, 1952

APPROVED J.P. Coolidge, Owner

By Same  
(Title)

