

Surface owned by **Core B. Hutson**.
 Address: **Mrs. Core B. Hutson, R.F.D. No. 1, Wallace, W. Va.**
 Coal owned by **Virginia A. Tetrick**.
 Address: **Mrs. Virginia A. Tetrick, P.O. Box 267, Clarksburg, W. Va.**

New Location **ON 800 MAP N39. 59s. 57 E4.**

Company **William Moss**
 Address **Salem, W. Va.**
 Farm **E. E. Smith**
 Tract **Acres 17 1/2** Lease No. _____
 Well (Farm) No. **2** Serial **177-30**
 Elevation (Spout Level) **1211.48**

STATE OF WEST VIRGINIA
 DEPARTMENT OF MINES
 OIL AND GAS DIVISION
 CHARLESTON

WELL LOCATION MAP
 FILE NO. **DOD-952-B**

Longitude 80. 30

McGlellan District, Doddridge County, W. Va.

By Wm. Moses, Salew, W. Va.

Abandoned under permit Dod-.....-A1

On.....acres.

Elevation,' L.

Drilling completed Oct. 24, 1902.

6" casing, 1957'; 5", 2402' (not visible).

Coal was encountered at 972-978'.

Oil well. Record to Dept. of Mines stamped Oct. 31, 1952.

Record to RGT from Mrs. Griffith Feb. 11, 1953. O.F.No. 900.

	Top.	Bottom.
Pittsburgh Coal	972	- 978
Dunkard Sand	1585	- 1725
Salt Sand	1830	- 1974
Maxton Sand	2060	- 2089
Big Lime	2225	- 2317
Big Injun Sand	2317	- 2417
Stroy Sand	2985	- 3029
Gordon Sand (1st pay, 3014-3055')	3047	- 3069
Total depth		3072



STATE OF WEST VIRGINIA
DEPARTMENT OF MINES
OIL AND GAS DIVISION

900

Permit No. 060-952-A

WELL RECORD

Oil or Gas Well (KIND)

Company Wm. Moses
 Address Salem, W. Va.
 Farm E. E. Smith Acres _____
 Location (waters) _____
 Well No. Two Elev. _____
 District McClellan County Doddridge
 The surface of tract is owned in fee by _____
 Address _____
 Mineral rights are owned by _____
 Address _____
 Drilling commenced _____
 Drilling completed Oct. 24, 1952 1902
 Date Shot _____ From _____ To _____
 With _____
 Open Flow /10ths Water in _____ Inch
 /10ths Merc. in _____ Inch
 Volume _____ Cu. Ft.
 Rock Pressure _____ lbs. _____ hrs.
 Oil _____ bbls., 1st 24 hrs.
 Fresh water _____ feet _____ feet
 Salt water _____ feet _____ feet

Casing and Tubing	Used in Drilling	Left in Well	Packers
Size			Kind of Packer
16			
13			
10			Size of
8 1/4			
6 1/2		1957	Depth set
5 3/16		2402	Not Visible.
3			Perf. top
2			Perf. bottom
Liners Used			Perf. top
			Perf. bottom


CASING CEMENTED _____ SIZE _____ No. Ft. _____ Date _____

COAL WAS ENCOUNTERED AT 972 FEET 72 INCHES

_____ FEET _____ INCHES _____ FEET _____ INCHES

_____ FEET _____ INCHES _____ FEET _____ INCHES

Formation	Color	Hard or Soft	Top	Bottom	Oil, Gas or Water	Depth Found	Remarks
Pgh. Coal			972	978			
Dubkard			1585	1725			
Salt			1830	1974			
Maxon			2060	2089			
Big Line			2225	2317			
Big Injun			2317	2417			
Stray			2985	3029			
Gordon			3047	3069			
1st Pay			3014	3055			
Total Depth				3072			

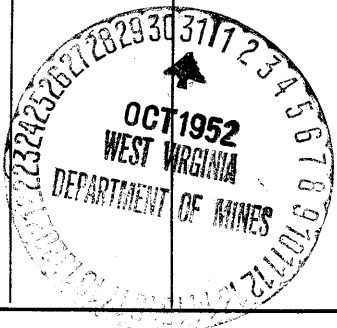

FEB 11 1953

WELL RECORD

Permit No. _____ (Oil or Gas Well) _____ (Liquor)

Company Wm. Moses
 Address Salem, Va.
 Farm E. I. Smith Acres _____
 Location (waters) Two
 Well No. Two Eley _____
 District McClellan County Doddridge
 The surface of tract is owned in fee by _____
 Address _____
 Mineral rights are owned by _____
 Address _____
 Drilling commenced _____
 Drilling completed Oct. 24, 1902 1902
 Date Shut _____
 With _____
 Open Pipe /10ths Water in _____ Inch
 /10ths Merc. in _____ Inch
 Volume _____ Cu. Ft.
 Rock Pressure _____ lbs.
 Oil _____ lbs., 1st 24 hrs.
 Fresh water _____ feet
 Salt water _____ feet

Casing and Tubing _____
 Used in Drilling _____
 Left in Well _____
 Remarks _____

Feet _____ Inches _____ Feet _____ Inches _____ Feet _____ Inches _____

Bottom _____
 Oil Gas or Water _____
 Feet _____ Inches _____ Feet _____ Inches _____ Feet _____ Inches _____

Top _____
 Hard or Soft _____
 Color _____
 Permian _____
 Pgh. Coal _____
 Dubbed _____
 Salt _____
 Maxon _____
 Big Lapis _____
 Big Injun _____
 Stray _____
 Gordon _____
 1st Pay _____
 Total Depth _____

William Moses
 Salem, Va.
 January 31, 1903
 McClellan
 Doddridge
 Two
 E. I. Smith
 Harry V. Maze
 Farm

AFFIDAVIT

STATE OF WEST VIRGINIA

County of Harrison

Abe Bailey and Geo. Moses being first duly sworn according to law depose and say that they are experienced in the work of plugging and lining oil and gas wells and were employed by William Moses well operator, who participated in the work of plugging and lining the above well, that said work was commenced on the 22nd day of November, 1902, and that the well was plugged and filled in the following manner:

PLUGS USED	SIZE & QUANT	DATE	DESCRIPTION OF MONUMENT
Clay	2975	1902	
Cement	2975	1902	
P. Bridge	2500	1902	5' Grushed stone on same.
Clay	2422	1902	Cement & Stone to 2422
Clay	2422	1902	
Cement	2200	1902	
P. Bridge	2000	1902	Cement and Stone to 1902
Clay	1902	1902	Pulled 2000 5-3/16" casing.
Cement	1800	1902	
Bridge	1500	1902	Cement and Stone to 1486
Clay	1486	1902	
Cement	1300	1902	
Clay	1188	1902	Pulled 1000 6-5/8" casing
Cement	1015	1902	
Clay	928	1902	
Cement	540	1902	
Clay	540	1902	
Clay	530	1902	
Clay	530	1902	

Concrete and Pipe Marker

and that the work of plugging and filling said well was completed on the 4th day of December, 1902

And further deponents said not

Sworn to and subscribed before me this _____ day of _____, 1902