

Latitude 39° 20'




0.475  
2.30W

Longitude 80° 45'

CRYSTAL LAKE CLUB  
N 81° 29' E

CRYSTAL LAKE CLUB

WILLIAM COLEMAN

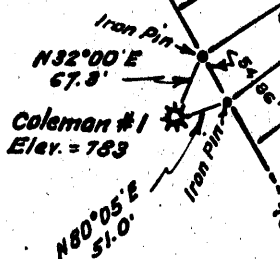

Surface is owned by Luther Pigott and Frank Michaels, whose postoffice address is West Union, West Va.

75' loc  
0.50 S 39 20  
0.04 W 80 47 30  
Calc 15' loc  
0.50 S 39 20  
2.27 W 80 45

No merchantable coal in this vicinity

New Location   
Drill Deeper   
Abandonment

Company **JAMES DROPPLEMAN, AGT.**

Address **West Union, W. Va.**

Farm **Wm. Coleman**

Tract \_\_\_\_\_ Acres \_\_\_\_\_ Lease No. \_\_\_\_\_

Well (Farm) No. **One** Serial No. \_\_\_\_\_

Elevation (Spirit Level) **783**

Quadrangle **West Union**

County **Doddridge** District **West Union**

Engineer *W. H. H. J.*

Engineer's Registration No. **1227**

File No. \_\_\_\_\_ Drawing No. \_\_\_\_\_

Date **October 1953** Scale **1" = 200'**

STATE OF WEST VIRGINIA  
DEPARTMENT OF MINES  
OIL AND GAS DIVISION  
CHARLESTON

WELL LOCATION MAP  
FILE NO. **DOD - 954-A**

+ Denotes location of well on United States Topographic Maps, scale 1 to 62,500, latitude and longitude lines being represented by border lines as shown.

- Denotes one inch spaces on border line of original tracing.

West Union District, Doddridge County, W. Va.  
 By J. F. Dreyfuss et al., 304 Court St., West Union, W. Va.  
 Abandoned under permit No. ....-A?

On.....acres.

Elevation, .....' L.

Date of completion, etc., not given.

Original operator: Murphy Oil Co. of Pa., West Union, W. Va.

10" casing, 365'; 8 1/2", 920'; 6 3/4", 1693'; 5", 1728'; all left in.

Gas well. Record to Dept. of Mines stamped Nov. 6, 1952.

Record to RCT from Mrs. Griffith Dec. 10, 1952. C.P. No. 878.

	Top.	Bottom.
Pittsburgh Coal	430	- 432
Big Dunkard Sand	905	- 925
1st Salt Sand	1210	- 1337
2nd Salt Sand	1355	- 1507
Little Linn	1650	- 1664
Pencil Cove	1664	- 1674
Blue Monday Sand	1674	- 1682
Break	1682	- 1686
Big Linn	1686	- 1757
Big Injun Sand (gas, 1832-1835')	1757	- 1837
Break	1837	- 1859
Squaw Sand	1859	- 1874
Total depth		1898



STATE OF WEST VIRGINIA  
DEPARTMENT OF MINES  
OIL AND GAS DIVISION

878

Permit No. 954-A

WELL RECORD

Oil or Gas Well \_\_\_\_\_ (KIND)


Company J. P. Droppleman et al  
 Address 304 Court Street - West Union, W. Va.  
 Farm Wm. F. Coleman Acres \_\_\_\_\_  
 Location (waters) \_\_\_\_\_  
 Well No. 1 Elev. 283  
 District West Union County Doddridge  
 The surface of tract is owned in fee by \_\_\_\_\_  
 Address \_\_\_\_\_  
 Mineral rights are owned by \_\_\_\_\_  
 Address \_\_\_\_\_  
 Drilling commenced \_\_\_\_\_  
 Drilling completed \_\_\_\_\_  
 Date Shot \_\_\_\_\_ From \_\_\_\_\_ To \_\_\_\_\_  
 With \_\_\_\_\_  
 Open Flow \_\_\_\_\_ /10ths Water in \_\_\_\_\_ Inch  
 \_\_\_\_\_ /10ths Merc. in \_\_\_\_\_ Inch  
 Volume \_\_\_\_\_ Cu. Ft.  
 Rock Pressure \_\_\_\_\_ lbs. \_\_\_\_\_ hrs.  
 Oil \_\_\_\_\_ bbls., 1st 24 hrs.  
 Fresh water \_\_\_\_\_ feet \_\_\_\_\_ feet  
 Salt water \_\_\_\_\_ feet \_\_\_\_\_ feet

Casing and Tubing	Used in Drilling	Left in Well	Packers
Size			
16			Kind of Packer _____
18			
10	365'	365'	Size of _____
8 1/4	920'	920'	
6 5/8	1693'	1693'	Depth set _____
5 3/16	1728'	1728'	
3			Perf. top _____
2			Perf. bottom _____
Liners Used			Perf. top _____
			Perf. bottom _____

CASING CEMENTED \_\_\_\_\_ SIZE \_\_\_\_\_ No. Ft. \_\_\_\_\_ Date \_\_\_\_\_

COAL WAS ENCOUNTERED AT \_\_\_\_\_ FEET \_\_\_\_\_ INCHES  
 \_\_\_\_\_ FEET \_\_\_\_\_ INCHES \_\_\_\_\_ FEET \_\_\_\_\_ INCHES  
 \_\_\_\_\_ FEET \_\_\_\_\_ INCHES \_\_\_\_\_ FEET \_\_\_\_\_ INCHES

Formation	Color	Hard or Soft	Top	Bottom	Oil, Gas or Water	Depth Found	Remarks
Pittsburgh Coal			430	432			
Big Dunkard			905	925			
1st Salt Sand			1210	1337			
2nd Salt Sand			1355	1507			
Little Line			1650	1664			
Pencil Cave			1664	1674			
Blue Monday			1674	1682			
Break			1682	1686			
Big Line			1686	1757			
Big Injun			1757	1837			
Gas			1832	1835			
Bottom Sand				1837			
Break			1837	1859			
Squaw			1859	1874			
Total Depth				1898			
					Original operator Murphy Oil Company of Pennsylvania West Union, W. Va.		

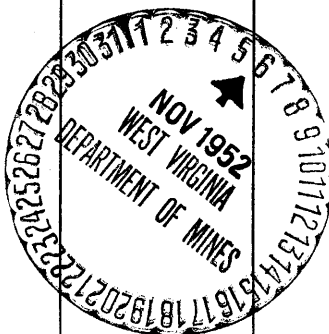

(Over) DEC 10 1952