


Latitude 39° 20'

Longitude 80° 50'

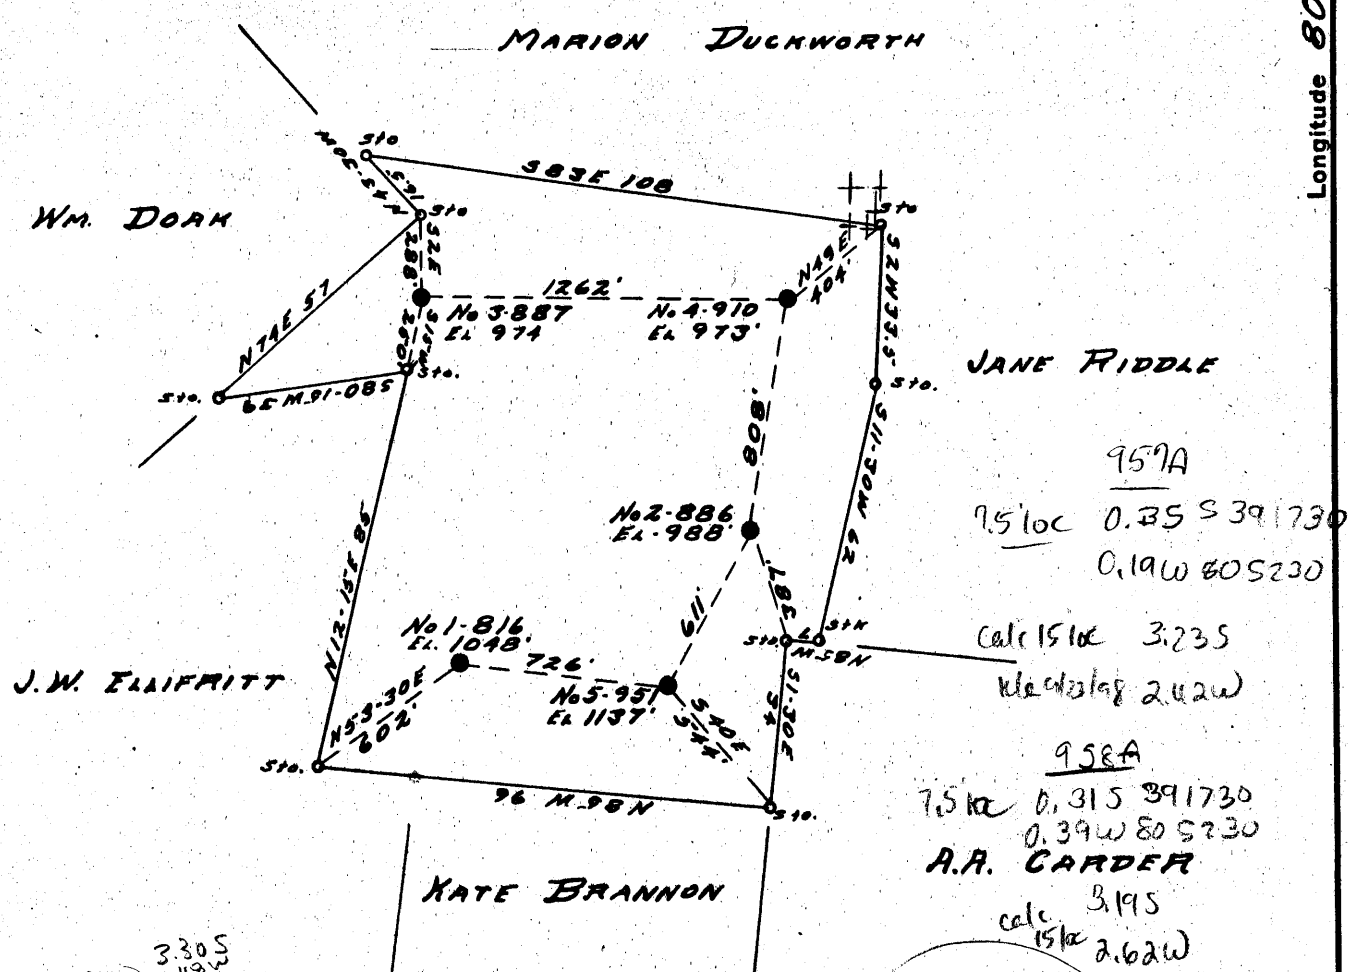

816) 3.30 S
2.43 W

886) 3.22 S
2.35 W

887) 3.11 S
2.48 W

910) 3.10 S
2.33 W

951) 3.31 S
2.40 W

956A - was 017 71110

0.47 S 39 1730

7.5' loc 0.33 W 80 5230

calc 3.34 S

15' 2.56 W

loc

W 242 W

DOD - 956-A - # 816 was 017 71110

DOD - 957-A - # 886

DOD - 958-A - # 887

DOD - 959-A - # 970 was 017 7110 6

DOD - 960-A - # 951 was 71111

New Location... 959A 7.5' loc calc 15' loc

Drill Deeper..... was 0.23 S 39 1730 3.11 S

Abandonment..... 71106 0.12 W 80 5230 2.35 W

960A 7.5' loc calc 15' loc

was 0.49 S 39 1730 3.36 S

71111 0.17 W 80 5230 2.41 W

Company WEINER BROTHERS

Address 1908 CLARK BLDG. PITTPA

Farm H. L. DUCKWORTH

Tract _____ Acres 27 Lease No. _____

Well (Farm) No. ALL W 222 Serial No. _____

Elevation (Spirit Level) AS SHOWN

Quadrangle WEST UNION SW.

County DODDRIDGE District CENTRAL

Engineer R. L. SWEENEY

Engineer's Registration No. _____

File No. _____ Drawing No. _____

11-25-52 Scale 1" = 40 FEET

STATE OF WEST VIRGINIA
DEPARTMENT OF MINES
OIL AND GAS DIVISION
CHARLESTON

WELL LOCATION MAP

FILE NO. See Above

+ Denotes location of well on United States Topographic Maps, scale 1 to 62,500, latitude and longitude lines being represented by border lines as shown.

- Denotes one inch spaces on border line of original tracing.



STATE OF WEST VIRGINIA
DEPARTMENT OF MINES
OIL AND GAS DIVISION

937

Permit No. 958-A

Oil or Gas Well _____ (KIND)



Company Weiner Brothers
Address Pittsburgh, Pa.
Farm H. L. Duckworth Acres 78
Location (waters) _____
Well No. 887 Elev. 974
District Central County Doddridge
The surface of tract is owned in fee by _____
Address _____
Mineral rights are owned by _____
Address _____
Drilling commenced March 1, 1919
Drilling completed March 29, 1919
Date Shot _____ From _____ To _____
With _____
Open Flow _____ /10ths Water in _____ Inch
_____ /10ths Merc. in _____ Inch
Volume _____ Cu. Ft.
Rock Pressure _____ lbs. _____ hrs.
Oil _____ bbls., 1st 24 hrs.
Fresh water _____ feet _____ feet
Salt water _____ feet _____ feet

Casing and Tubing	Used in Drilling	Left in Well	Packers
Size			
16			Kind of Packer
13			
10			Size of
8 1/4			
6%	<u>1100 1885</u>	<u>1885 985</u>	Depth set
<u>5 3/16 5-1/2"</u>	<u>1911</u>	<u>1911</u>	<u>111</u>
3			Perf. top
2	<u>1895</u>	<u>1895</u>	Perf. bottom
Liners Used			Perf. top
			Perf. bottom

CASING CEMENTED _____ SIZE _____ No. Ft. _____ Date _____

Coal not marketable
COAL WAS ENCOUNTERED AT _____ FEET _____ INCHES
_____ FEET _____ INCHES _____ FEET _____ INCHES
_____ FEET _____ INCHES _____ FEET _____ INCHES

Formation	Color	Hard or Soft	Top	Bottom	Oil, Gas or Water	Depth Found	Remarks
Little Dunkard			965	985			
Big Dunkard			1075	1095			
Gas Sand			1100	1174			
First Salt Sand			1385	1440			
Second Salt Sand			1454 ?	1448			
Maxton			1790	1824			
Little Lime			1830	1845			
Pencil Cave			1845	1862			
Big Lime			1862	1926			
Big Injun			1926	1985			
Total Depth				1985			
							Gas 1936-40 Oil 1963-1968 - shot

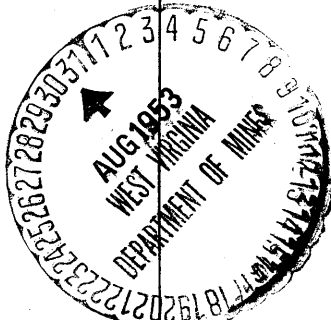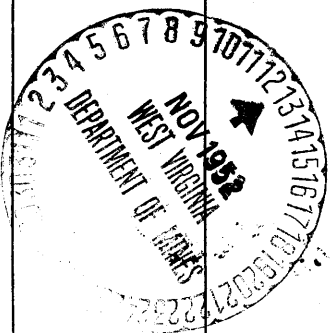

(Over)

OCT 1 1953