

DOD-961-A - # 675 #1  
 DOD-962-A - # 856 #3  
 DOD-963-A - # 893 #4  
 DOD-964-A - # 921 #5  
 DOD-966-A - # 990 #7 → NDW  
 DOD-967-A - # 993 #8 → NDW  
 DOD-968-A - # 1040 #9  
 WELL # 950 - ABANDONED UNDER DRILL  
 PERMIT - DOD-167

New Location...   
 Drill Deeper.....   
 Abandonment.....

Company WEINER BROTHERS  
 Address 1908 CLARK BLDG. PITT. PA.  
 Farm BA. CORDER  
 Tract \_\_\_\_\_ Acres 96 Lease No. \_\_\_\_\_  
 Well (Farm) No. ALL WELLS Serial No. \_\_\_\_\_  
 Elevation (Spirit Level) AS SHOWN  
 Quadrangle WEST UNION SW 9 SE  
 County DODDRIDGE District CENTRAL  
 Engineer F.L. Sweeney  
 Engineer's Registration No. \_\_\_\_\_  
 File No. \_\_\_\_\_ Drawing No. \_\_\_\_\_  
 Date 11-25-52 Scale 1" = 40 FEET

STATE OF WEST VIRGINIA  
 DEPARTMENT OF MINES  
 OIL AND GAS DIVISION  
 CHARLESTON

**WELL LOCATION MAP**  
 FILE NO. SEE ABOVE

+ Denotes location of well on United States Topographic Maps, scale 1 to 62,500, latitude and longitude lines being represented by border lines as shown.  
 - Denotes one inch spaces on border line of original tracing.

A. A. GARDNER NO. 675 WELL.

961A

Central District, Doddridge County, W. Va.  
 By Weiner Brothers, Pittsburgh, Pa.  
 Abandoned under permit Dod-.....-A?  
 On 96 acres.

Elevation, .....! L.

Drilling commenced Sept. 12, 1916; completed (to 1776') Nov. 16, 1916.

Drilling deeper commenced April 4, 1919; completed April 17, 1919 (to 1982')  
 well was shot.

6 $\frac{5}{8}$ " casing, 1530'; 5 $\frac{3}{16}$ ", 1870'; 2" tubing, 1982'; all left in.

Gas well in Maxton at first; oil well in Big Injun on deepening.

Record to Dept. of Mines stamped Nov. 14, 1952, and Jan. 6, 1953.

Record to RCT from Mrs. Griffith Feb. 11, 1953. O.F.No. 888.

	Top.	Bottom.
Little Dunkard Sand	1035	- ....
Big Dunkard Sand	1135	- 1165
Gas Sand	1420	- 1460
1st Salt Sand	1500	- 1600
Maxton Sand (gas, 1756-1766')	1754	- 1822
1st total depth		1776
DEEPENED:		
Little Lime	1840	- 1851
Pencil Cave	1851	- 1863
Big Lime	1863	- 1945
Big Injun Sand (oil, 1964-9'; shot)	1945	- ....
Total depth		1982



888

STATE OF WEST VIRGINIA  
DEPARTMENT OF MINES  
OIL AND GAS DIVISION

WELL RECORD

Permit No. 000-961-A



Oil or Gas Well \_\_\_\_\_  
(KIND)

Company Weiner Brothers  
 Address Pittsburgh, Pa.  
 Farm A. A. Carder Acres 96  
 Location (waters) \_\_\_\_\_  
 Well No. Central (675) Elev. 983  
 District Central County Doddridge  
 The surface of tract is owned in fee by \_\_\_\_\_  
 Address \_\_\_\_\_  
 Mineral rights are owned by \_\_\_\_\_  
 Address \_\_\_\_\_  
 Drilling commenced 9/12/16 (D.D. 4/4/1919)  
 Drilling completed 11/16/16 (DD 4/17/1919)  
 Date Shot yes From \_\_\_\_\_ To \_\_\_\_\_  
 With \_\_\_\_\_  
 Open Flow \_\_\_\_\_ /10ths Water in \_\_\_\_\_ Inch  
 \_\_\_\_\_ /10ths Merc. in \_\_\_\_\_ Inch  
 Volume \_\_\_\_\_ Cu. Ft.  
 Rock Pressure \_\_\_\_\_ lbs. \_\_\_\_\_ hrs.  
 Oil \_\_\_\_\_ bbls., 1st 24 hrs.  
 Fresh water \_\_\_\_\_ feet \_\_\_\_\_ feet  
 Salt water \_\_\_\_\_ feet \_\_\_\_\_ feet

Casing and Tubing	Used in Drilling	Left in Well	Packers
Size			
16			Kind of Packer
13			
10			Size of
8 1/2			
6 1/2	<u>1530</u>	<u>1530</u>	Depth set
5 3/16	<u>1870</u>	<u>1870</u>	
3			Perf. top
2	<u>1982</u>	<u>1982</u>	Perf. bottom
Liners Used			Perf. top
			Perf. bottom

CASING CEMENTED \_\_\_\_\_ SIZE \_\_\_\_\_ No. Ft. \_\_\_\_\_ Date \_\_\_\_\_  
 COAL WAS ENCOUNTERED AT \_\_\_\_\_ FEET \_\_\_\_\_ INCHES  
 \_\_\_\_\_ FEET \_\_\_\_\_ INCHES FEET \_\_\_\_\_ INCHES  
 \_\_\_\_\_ FEET \_\_\_\_\_ INCHES FEET \_\_\_\_\_ INCHES

Formation	Color	Hard or Soft	Top	Bottom	Oil, Gas or Water	Depth Found	Remarks
Little Dunkard			1035	?			
Big Dunkard			1135	1165			
Gas Sand			1120	1160			
1st Salt Sand			1500	1600			
Maxton			1754	1822			Gas 1756'-1766') 1st Total Depth 1776'
Little Lime			1840	1851			
Pencil Cave			1851	1863			
Big Lime			1863	1945			
Big Inj n			1945				
Total Depth				1982			Oil 1964-9' - shot

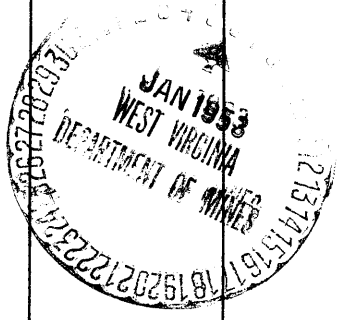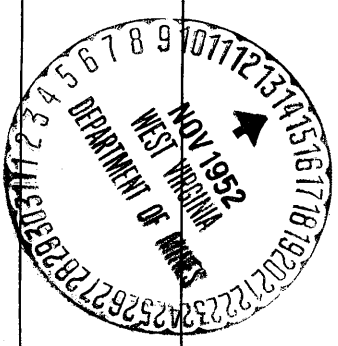

FEB 12 1953