

Company C. O. TRAVIS

Address WEST UNION, W. VA.

Farm JOHN ADAMS

Tract _____ Acres 84.3 Lease No. _____

Well (Farm) No. 1 Serial No. _____

Elevation (Spirit Level) 1096

Quadrangle WEST UNION

County DODDRIDGE District WEST UNION

Engineer George R. Clarke
 Surveyed by Hoher W. Myers
 Engineer's Registration No. 102

File No. _____ Drawing No. _____

Date MARCH 2, 1953 Scale 1" = 600'

STATE OF WEST VIRGINIA
 DEPARTMENT OF MINES
 OIL AND GAS DIVISION
 CHARLESTON

WELL LOCATION MAP
 FILE NO. D00-982-A

+ Denotes location of well on United States Topographic Maps, scale 1 to 62,500, latitude and longitude lines being represented by border lines as shown.

- Denotes one inch spaces on border line of original tracing.



STATE OF WEST VIRGINIA
DEPARTMENT OF MINES
OIL AND GAS DIVISION

707

WELL RECORD

Permit No. Prod-982-A

Oil or Gas Well Gas

(KIND)


Company C. O. Travis
Address West Union, W. Va.
Farm Eli Nutter Acres 208
Location (waters) Piggin Run
Well No. 1 Elev. 1096
District West Union County Doddridge
The surface of tract is owned in fee by John Adams
Salem, W. Va. Address _____
Mineral rights are owned by John Adams
Salem, W. Va. Address _____
Drilling commenced _____
Drilling completed _____
Date Shot _____ From _____ To _____
With _____
Open Flow _____ /10ths Water in _____ Inch
_____ /10ths Merc. in _____ Inch
Volume _____ Cu. Ft.
Rock Pressure _____ lbs. _____ hrs.
Oil _____ bbls., 1st 24 hrs.
Fresh water _____ feet _____ feet
Salt water _____ feet _____ feet

Casing and Tubing	Used in Drilling	Left in Well	Packers
Size			
16			Kind of Packer
13			
10			Size of
8 3/4	1014	20'	
6 3/4	1361	1361	Depth set
5 3/16			
3			Perf. top
2			Perf. bottom
Liners Used			Perf. top
			Perf. bottom

CASING CEMENTED _____ SIZE _____ No. Ft. _____ Date _____

COAL WAS ENCOUNTERED AT _____ FEET _____ INCHES
_____ FEET _____ INCHES _____ FEET _____ INCHES
_____ FEET _____ INCHES _____ FEET _____ INCHES

Formation	Color	Hard or Soft	Top	Bottom	Oil, Gas or Water	Depth Found	Remarks
Dunkard			1096	1140			
Gas Sand			1395	1430			
1st Salt Sand			1520	1605			
2nd Salt Sand			1660	1680			
Maxon			1930	1964			
Little Lime			1975	1984			
Pencil Cave			1984	1990			
Big Lime			2015	2080			
Big Ingun Sand			2080	2170	Gas Show	2119	
Squaw Sand			2180	2208	Gas Show	2193	
Gordon Sand			2782	2792			
4th Sand			2812	2818	Gas	2814	
Total Depth				2824			

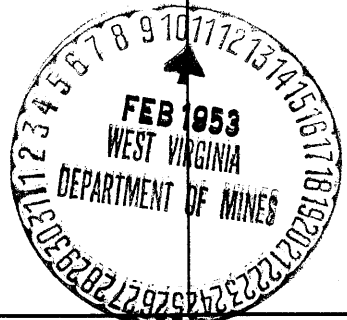

(Over) JUN 10 1953

