

Latitude 39° 20'

Longitude 80° 50'

SMITH HRS.


F. P. DOTSON HRS
63 A. 64 p.

MASON

DOTSON

DARNELL

MASON

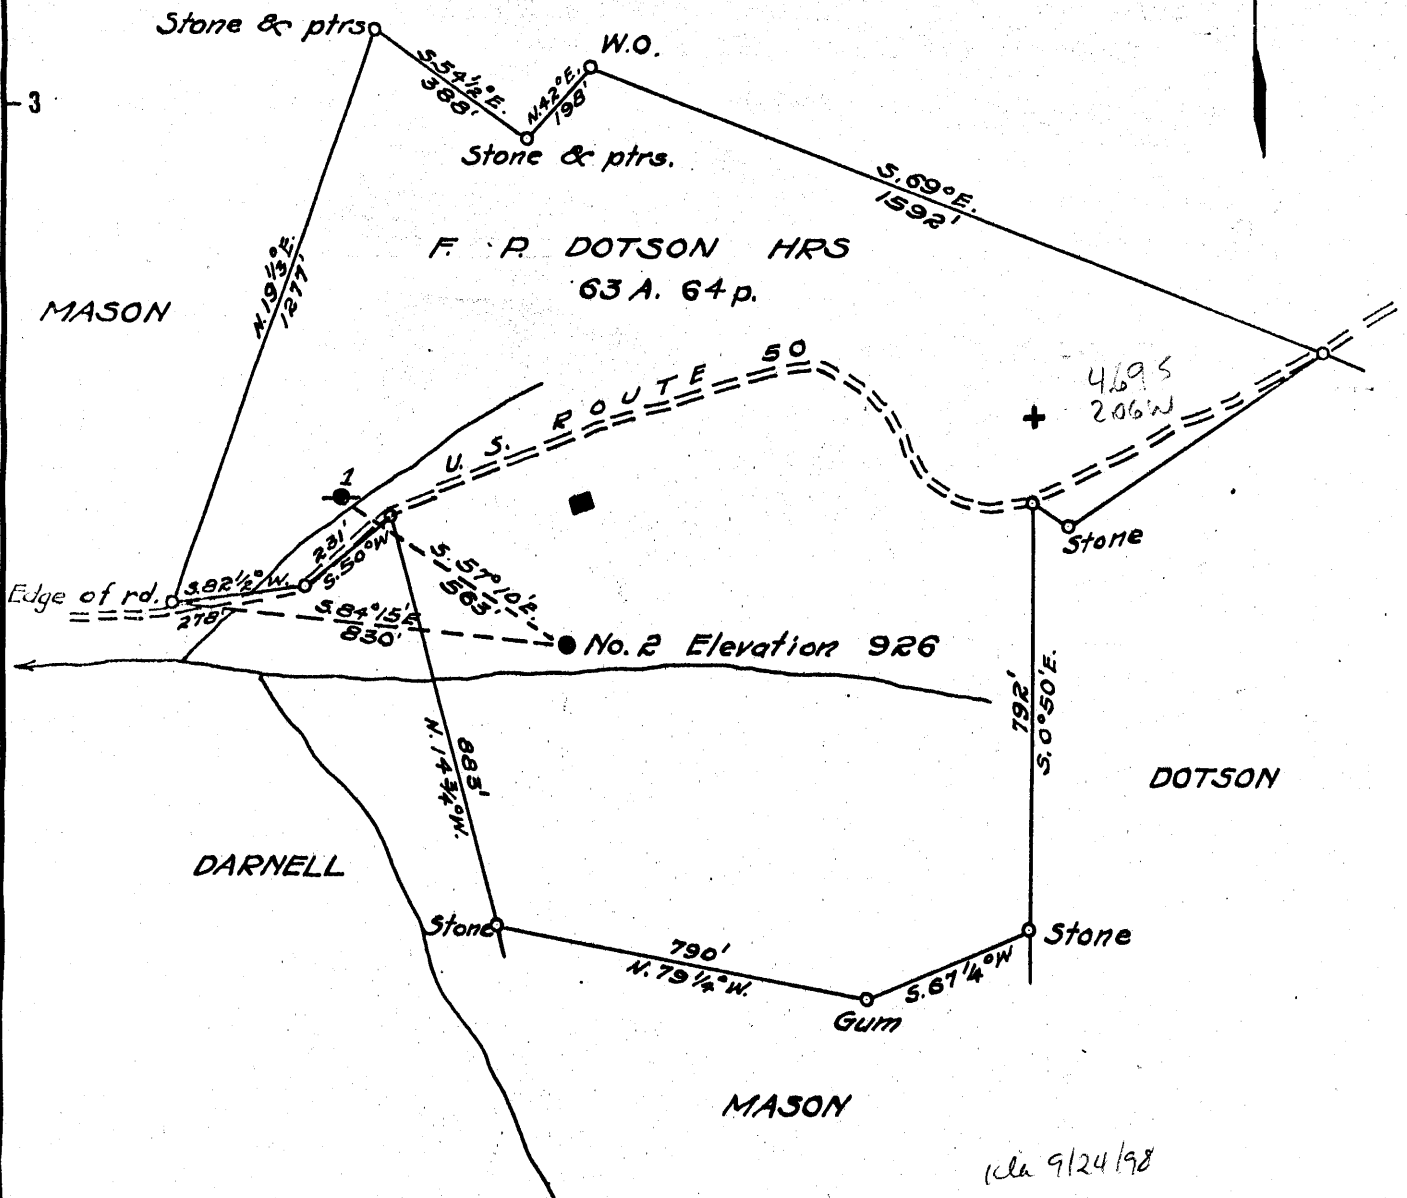

New Location..
 Drill Deeper.....
 Abandonment.....

7.5 loc
 124539.730
 0.056.20 5230

15' loc calc
 4.725
 2.28W

aka 9/24/98

Company MACKAY & WHITE
 Address RAVEN ROCK, W. VA.
 Farm F. P. DOTSON HRS.
 Tract _____ Acres 63A + Lease No. _____
 Well (Farm) No. 2 Serial No. _____
 Elevation (Spirit Level) 926
 Quadrangle WEST UNION
 County DODDRIDGE District CENTRAL
 Engineer B. F. RINEHART
 Engineer's Registration No. 648
 File No. _____ Drawing No. 95R-CD
 Date May 18, 1953 Scale 1 in = 400 ft.

STATE OF WEST VIRGINIA
 DEPARTMENT OF MINES
 OIL AND GAS DIVISION
 CHARLESTON

WELL LOCATION MAP
 FILE NO. DOD-1003-A

+ Denotes location of well on United States Topographic Maps, scale 1 to 62,500, latitude and longitude lines being represented by border lines as shown.

- Denotes one inch spaces on border line of original tracing.



STATE OF WEST VIRGINIA
DEPARTMENT OF MINES
OIL AND GAS DIVISION

932

WELL RECORD

Permit No. 1003 A

Oil or Gas Well X (KIND)


Company Wade & White
Address Raven Rock, W.Va.
Farm F.P. Dotson hrs. Acres 63
Location (waters) U.S. Route 50
Well No. 2 Elev. 926
District Central County Doddridge
The surface of tract is owned in fee by same
Address same
Mineral rights are owned by same
Address same
Drilling commenced 1919
Drilling completed _____
Date Shot _____ From _____ To _____
With _____
Open Flow _____ /10ths Water in _____ Inch
_____ /10ths Merc. in _____ Inch
Volume _____ Cu. Ft.
Rock Pressure _____ lbs. _____ hrs.
Oil _____ bbls., 1st 24 hrs.
Fresh water _____ feet _____ feet
Salt water _____ feet _____ feet

Casing and Tubing	Used in Drilling	Left in Well	Packers
Size			Kind of Packer
16			
13			
10			Size of
8 1/4	315		
6 3/4	1182		Depth set
5 3/16	1907	1907	
3			Perf. top
2			Perf. bottom
Liners Used		1990	Perf. top
			Perf. bottom

CASING CEMENTED _____ SIZE _____ No. Ft. _____ Date _____

COAL WAS ENCOUNTERED AT _____ FEET _____ INCHES
_____ FEET _____ INCHES _____ FEET _____ INCHES
_____ FEET _____ INCHES _____ FEET _____ INCHES

Formation	Color	Hard or Soft	Top	Bottom	Oil, Gas or Water	Depth Found	Remarks
		1st. Salt Sand		1485 to 1505			
		2nd. " "		1610 to 1690			
		Maxon Sand		1795 to 1809			
		Big Lime		1904 to 1982			
		Injun sand		1982			
		Total Debth.		2067			

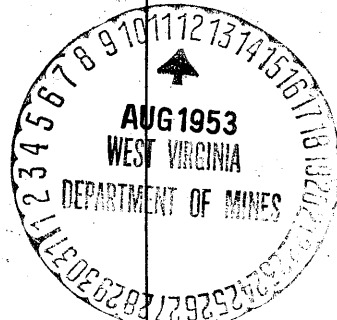

Formation	Color	Hard or Soft	Top	Bottom	Oil, Gas or Water	Depth Found	Remarks
							56

Date Aug 10, 1953

APPROVED Edw E Mott, Owner

By Mottner
(Title)