





STATE OF WEST VIRGINIA  
DEPARTMENT OF MINES  
OIL AND GAS DIVISION

958

1007-A

WELL RECORD

Permit No. 1007-A Oil or Gas Well X (KIND)


Company <u><del>Walker, F. 2. W. Va.</del></u>	Casing and Tubing	Used in Drilling	Left in Well	Packers
Address <u>Walker, F. 2. W. Va.</u>				
Farm <u>W.A. Mason</u> Acres <u>30</u>	Size			
Location (waters) <u>HUGANS RIVER</u>	16			Kind of Packer
Well No. <u>4</u> Elev. <u>1923</u>	13			
District <u>Central</u> County <u>DODDRIDGE</u>	10	<u>280'</u>	<u>none</u>	Size of
The surface of tract is owned in fee by <u>C.J. Gilpin</u>	8 1/4	<u>1258'</u>	<u>none</u>	
<u>831 south ave Toledo, Ohio</u>	6 5/8	<u>1953</u>	<u>1953</u>	Depth set
Mineral rights are owned by <u>W.A. Mason, Mrs</u>	5 3/16			
<u>Greenwood rt, 1 W. Va</u>	3			Perf. top
Drilling commenced <u>1921</u>	2	<u>2010'</u>	<u>none</u>	Perf. bottom
Drilling completed <u>same</u>	Liners Used			Perf. top
Date Shot _____ From _____ To _____				Perf. bottom
With _____				

Open Flow /10ths Water in \_\_\_\_\_ Inch  
 /10ths Merc. in \_\_\_\_\_ Inch  
 Volume \_\_\_\_\_ Cu. Ft.  
 Rock Pressure \_\_\_\_\_ lbs. \_\_\_\_\_ hrs.  
 Oil \_\_\_\_\_ bbls., 1st 24 hrs.  
 Fresh water \_\_\_\_\_ feet \_\_\_\_\_ feet  
 Salt water \_\_\_\_\_ feet \_\_\_\_\_ feet

CASING CEMENTED \_\_\_\_\_ SIZE \_\_\_\_\_ No. Ft. \_\_\_\_\_ Date \_\_\_\_\_

COAL WAS ENCOUNTERED AT \_\_\_\_\_ FEET \_\_\_\_\_ INCHES  
 \_\_\_\_\_ FEET \_\_\_\_\_ INCHES \_\_\_\_\_ FEET \_\_\_\_\_ INCHES  
 \_\_\_\_\_ FEET \_\_\_\_\_ INCHES \_\_\_\_\_ FEET \_\_\_\_\_ INCHES

Formation	Color	Hard or Soft	Top	Bottom	Oil, Gas or Water	Depth Found	Remarks
clay & red rock			000	300'			
red cave			300'	950'			
slate			950'	1235'			
big dunkard			1235'	1250'			
slate & shale			1250'	1690'			
salt sand			1690'	1731'			
lime & slate			1731'	1975'			
Injun sand			1975'	2010'			
			total depth 2010'				

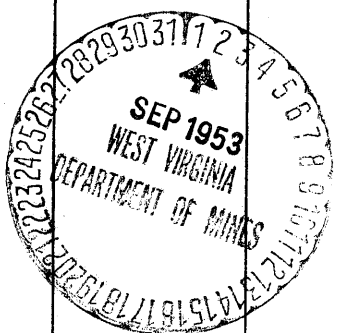

(Over) JAN 2 1954  
JAN 2 RECD

Formation	Color	Hard or Soft	Top	Bottom	Oil, Gas or Water	Depth Found	Remarks
							b6

Date 3-25, 1953

APPROVED ~~Ricard Smith~~ ~~Frank K. Kibbide~~, Owner

By ~~B. R. Piersol~~  
(Title)