

Company OTIS HARDIN

Address WILLIAMSTOWN, W. VA.

Farm D. B. ADAMS

Tract _____ Acres 40. Lease No. _____

Well (Farm) No. 1 Serial No. _____

Elevation (Spirit Level) 1080

Quadrangle HOLBROOK

County DODDRIDGE District CENTRAL

Engineer B. F. RINEHART

Engineer's Registration No. 648

File No. _____ Drawing No. _____

Date 9-28-53 Scale 1" = 300'

STATE OF WEST VIRGINIA
DEPARTMENT OF MINES
OIL AND GAS DIVISION
CHARLESTON

WELL LOCATION MAP

FILE NO. DOD-1010-R

+ Denotes location of well on United States Topographic Maps, scale 1 to 62,500, latitude and longitude lines being represented by border lines as shown.

- Denotes one inch spaces on border line of original tracing.



STATE OF WEST VIRGINIA
DEPARTMENT OF MINES
OIL AND GAS DIVISION

948

Quadrangle 1010-A

WELL RECORD

Permit No. _____


Oil or Gas Well _____ (KIND)

Company OTIS HARDIN
Address RFD - WILLIAMSTOWN, W. VA.
Farm D. B. ADAMS Acres 50
Location (waters) _____
Well No. 1 Elev. 1080'
District Central County Doddridge
The surface of tract is owned in fee by _____
Address _____
Mineral rights are owned by _____
Address _____
Drilling commenced _____
Drilling completed _____
Date Shot _____ From _____ To _____
With _____
Open Flow _____ /10ths Water in _____ Inch
_____ /10ths Merc. in _____ Inch
Volume _____ Cu. Ft.
Rock Pressure _____ lbs. _____ hrs.
Oil _____ bbls., 1st 24 hrs.
Fresh water _____ feet _____ feet
Salt water _____ feet _____ feet

Casing and Tubing	Used in Drilling	Left in Well	Packers
Size			Kind of Packer
16			
13			
10			Size of
8 1/4			
6 5/8	<u>100' Approx.</u>	<u>1800'</u>	Depth set
5 3/16			
3			Perf. top
2			Perf. bottom
Liners Used			Perf. top
			Perf. bottom

CASING CEMENTED _____ SIZE _____ No. Ft. _____ Date _____
COAL WAS ENCOUNTERED AT _____ FEET _____ INCHES
_____ FEET _____ INCHES FEET _____ INCHES
_____ FEET _____ INCHES FEET _____ INCHES

Formation	Color	Hard or Soft	Top	Bottom	Oil, Gas or Water	Depth Found	Remarks
NO ACTUAL RECORD OF THIS WELL - used record of well No. 3 on the F. M. Britton Farm Central District, Doddridge County which is 140' from the D. B. Adams well No. 1							
Big Dunkard	- Approx		1350'	1400'			
Big Injun	- Approx		2250'	2345			

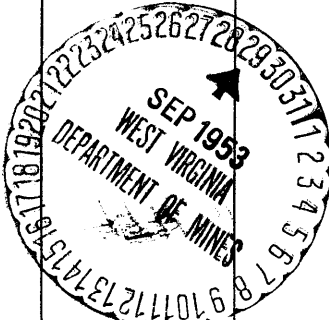

JAN 2 1954

(Over) JAN 2 REC'D