


Latitude 39° 20'

Longitude 80° 50'

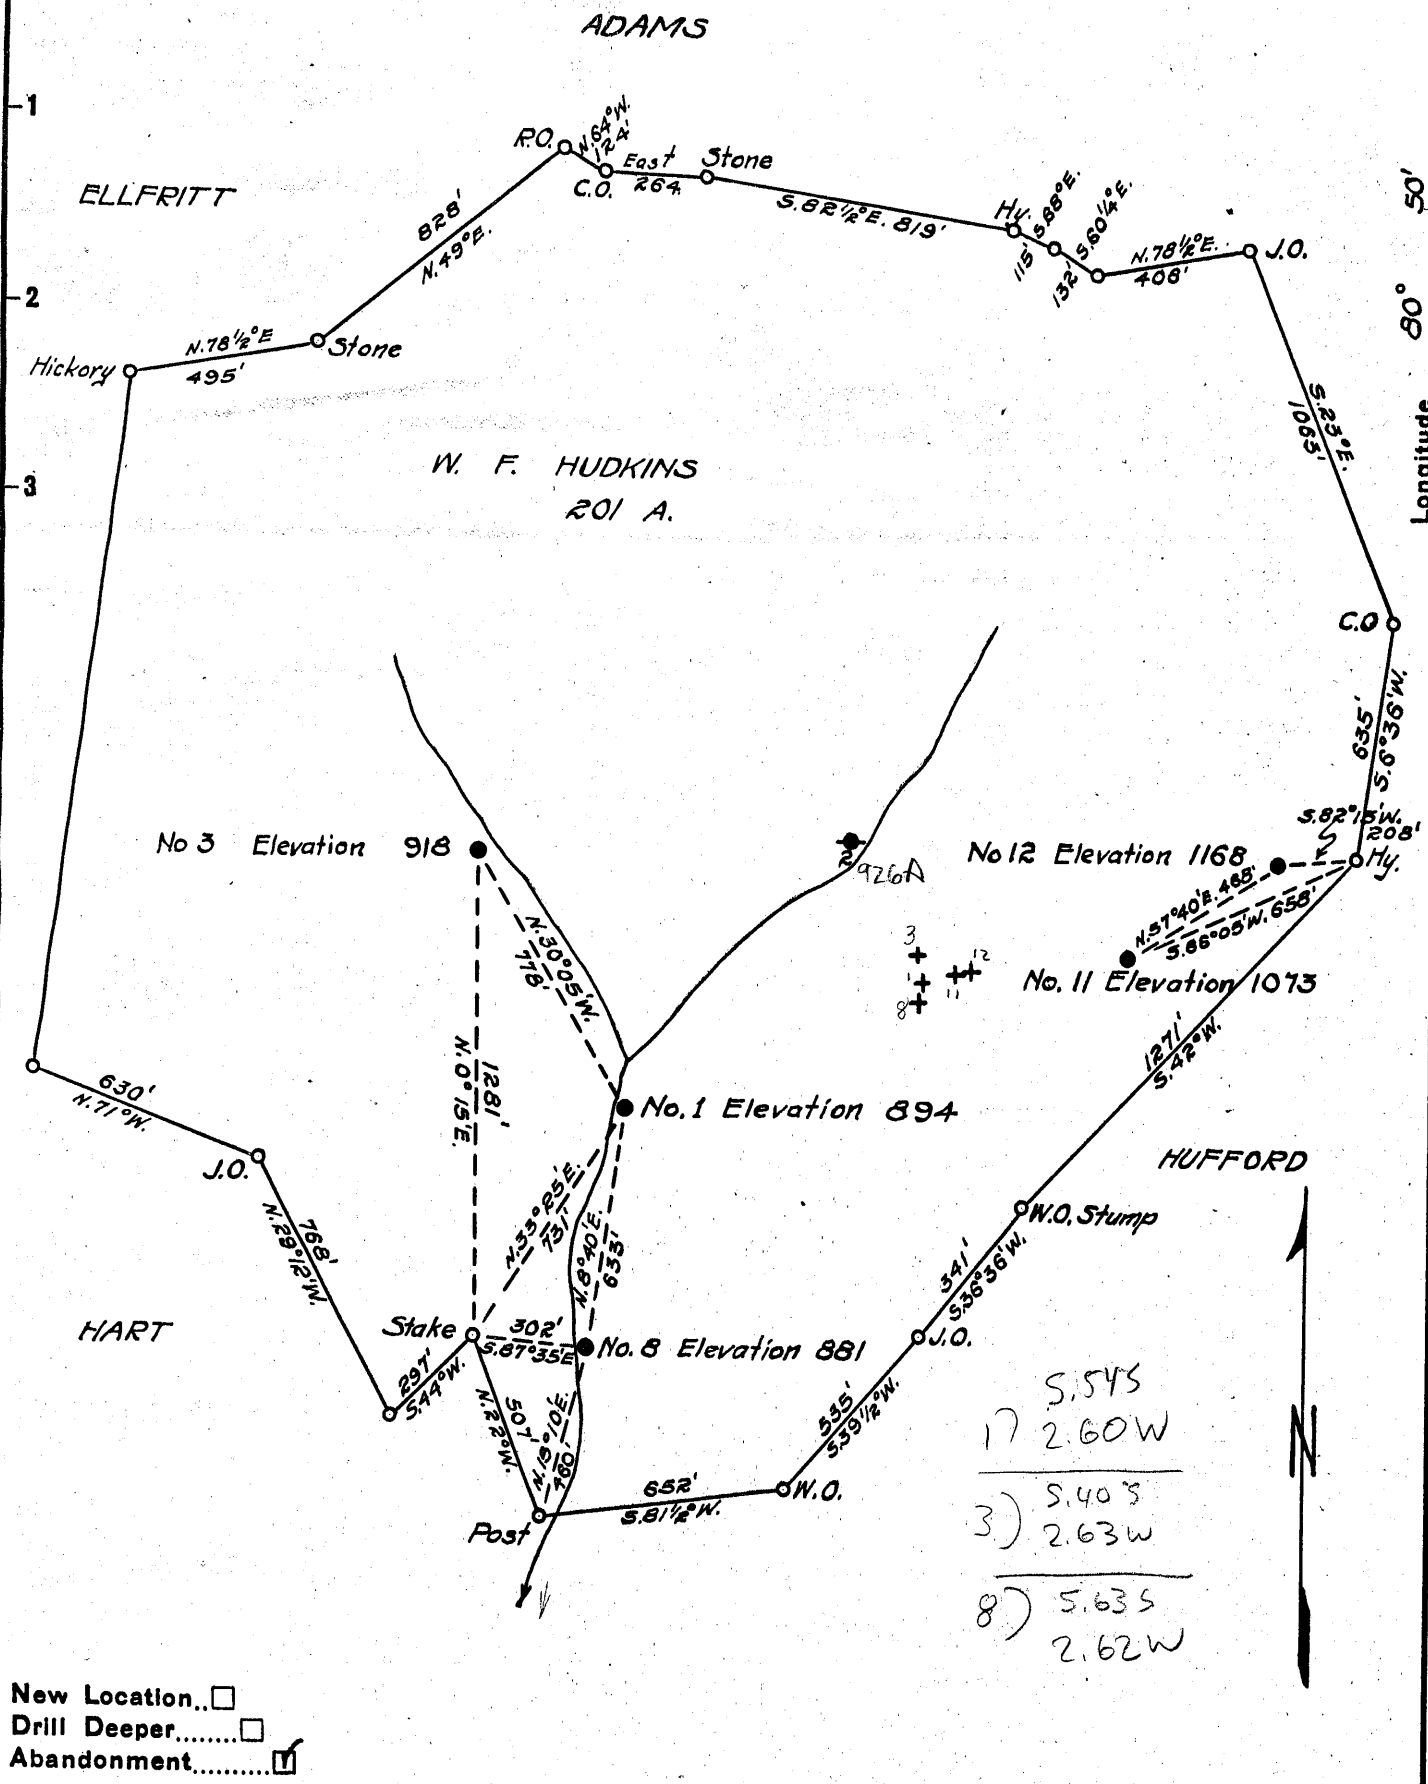

New Location..
 Drill Deeper.....
 Abandonment.....

Company MACKAY & WHITE
 Address RAVEN ROCK, W. VA.
 Farm W. F. HUDKINS
 Tract _____ Acres 201 Lease No. _____
 Well (Farm) No. 1, 3, 8, 11, 12 Serial No. _____
 Elevation (Spirit Level) 894, 918, 881, 1073, 1168
 Quadrangle WEST UNION
 County DODDRIDGE District CENTRAL
 Engineer B. F. RINEHART
 Engineer's Registration No. 648
 File No. _____ Drawing No. 978-CD
 Date Sept. 23, 1953 Scale 1 in. = 500 ft.

STATE OF WEST VIRGINIA
 DEPARTMENT OF MINES
 OIL AND GAS DIVISION
 CHARLESTON

WELL LOCATION MAP
 FILE NO. DOD-1013-A-#1
~~DOD-1014-A-#3~~
DOD-1015-A-#8

+ Denotes location of well on United States Topographic Maps, scale 1 to 62,500, latitude and longitude lines being represented by border lines as shown.

- Denotes one inch spaces on border line of original tracing.



STATE OF WEST VIRGINIA
DEPARTMENT OF MINES
OIL AND GAS DIVISION

905

WELL RECORD

Permit No. 1015A

Oil or Gas Well X (KIND)

Company Maekey & White
Address Raven Rock, W. Va.
Farm W. F. Hudkins Acres 301
Location (waters) Leason Run
Well No. 8 Elev 881
District Central County Doddridge
The surface of tract is owned in fee by W. F. Hudkins
Greenwood, W. Va. Address _____
Mineral rights are owned by same
Address _____


Casing and Tubing	Used in Drilling	Left in Well	Packers
Size			Kind of Packer
16			
13			
10 <u>335</u>		<u>none</u>	Size of
8 1/2 <u>1080</u>		"	
6 5/8 <u>1860</u>		<u>1860</u>	Depth set
5 3/16			
3			Perf. top
2		<u>1985</u>	Perf. bottom
Liners Used			Perf. top
			Perf. bottom

Drilling commenced _____
Drilling completed 1921 about
Date Shot _____ From _____ To _____
With _____

Open Flow _____ /10ths Water in _____ Inch
_____ /10ths Merc. in _____ Inch
Volume Not now producing Cu. Ft.
Rock Pressure _____ lbs. _____ hrs.
Oil _____ bbls., 1st 24 hrs.
Fresh water _____ feet _____ feet
Salt water _____ feet _____ feet

CASING CEMENTED _____ SIZE _____ No. Ft. _____ Date _____
COAL WAS ENCOUNTERED AT _____ FEET _____ INCHES
_____ FEET _____ INCHES FEET _____ INCHES
_____ FEET _____ INCHES FEET _____ INCHES

Formation	Color	Hard or Soft	Top	Bottom	Oil, Gas or Water	Depth Found	Remarks
Second Salt Sand		1430 to	1450				
3rd Salt Sand		1530 to	1690				
Maxon Sand		1790 to	1820				
Big Lime		1850 to	1929				
Injun sand		1929 to	1972				
Bottom hole		1985					

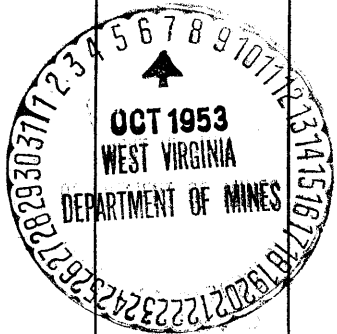

(Over)

MAY 10 1954

Formation	Color	Hard or Soft	Top	Bottom	Oil, Gas or Water	Depth Found	Remarks
							21

Date Oct. 51, 1953

APPROVED Mackey of White, Owner

By Lowie White
(Title)