

New Location...

Drill Deeper.....

Abandonment.....

Company MACKEY & WHITE

Address RAVEN ROCK, W. VA.

Farm W. F. HUDKINS

Tract _____ Acres 201 Lease No. _____

Well (Farm) No. 3, 8, 11, 12 Serial No. _____

Elevation (Spirit Level) 894, 918, 881, 1073, 1168

Quadrangle WEST UNION

County DODDRIDGE District CENTRAL

Engineer B. F. RINEHART

Engineer's Registration No. 648

File No. _____ Drawing No. 978-CD

Date Sept. 23, 1953 Scale 1 in. = 500 ft

STATE OF WEST VIRGINIA
DEPARTMENT OF MINES
OIL AND GAS DIVISION
CHARLESTON

WELL LOCATION MAP

FILE NO. DOD 1018-A-#1
DOD 1019-A-#3
DOD 1018-A-#8

+ Denotes location of well on United States Topographic Maps, scale 1 to 62,500, latitude and longitude lines being represented by border lines as shown.

- Denotes one inch spaces on border line of original tracing.

W. F. HUDKINS Nos. 3, 8, 11, & 12 - MACKEY & WHITE - DOD 1018-19



STATE OF WEST VIRGINIA
DEPARTMENT OF MINES
OIL AND GAS DIVISION

WELL RECORD

969

Permit No. 1018-A

Oil or Gas Well (KIND)


Company Mackey & White
Address Raven Rock, West Va.
Farm W.F. Hudkins Acres 301
Location (waters) Leason Run
Well No. 11 Elev. 1073
District Central County Doddridge
The surface of tract is owned in fee by W.F. Hudkins
Greenwood Address West Va.
Mineral rights are owned by Same
Address _____
Drilling commenced 1917
Drilling completed _____
Date Shot _____ From _____ To _____
With _____

Casing and Tubing	Used in Drilling	Left in Well	Packers
Size			
16			Kind of Packer
13			
10	<u>240</u>	<u>none</u>	Size of
8 1/4	<u>1395</u>	<u>"</u>	
6 1/2	<u>2059</u>	<u>2059</u>	Depth set
5 3/16	<u>2086 ft. run</u>		
3	<u>1940 on hook</u>		Perf. top
2	<u>wall packer.</u>		Perf. bottom
Liners Used	<u>2189 2" tubing</u>		Perf. top
			Perf. bottom

Open Flow _____ /10ths Water in _____ Inch
_____ /10ths Merc. in _____ Inch
Volume _____ Cu. Ft.
Rock Pressure _____ lbs. _____ hrs.
Oil Not now producing bbls., 1st 24 hrs.
Fresh water _____ feet _____ feet
Salt water _____ feet _____ feet

CASING CEMENTED _____ SIZE _____ No. Ft. _____ Date _____
COAL WAS ENCOUNTERED AT _____ FEET _____ INCHES
_____ FEET _____ INCHES FEET _____ INCHES
_____ FEET _____ INCHES FEET _____ INCHES

Formation	Color	Hard or Soft	Top	Bottom	Oil, Gas or Water	Depth Found	Remarks
<u>1st. salt sand</u>			<u>1895</u>	<u>1660</u>			
<u>2nd. Salt sand</u>			<u>1750</u>	<u>1800</u>			
<u>Maxon sand</u>			<u>1990</u>	<u>2031</u>			
<u>Big Lime</u>			<u>2050</u>	<u>2136</u>			
<u>Injun Sand</u>			<u>2136</u>	<u>2183</u>			
			<u>Bottom Hole 2189</u>		<u>Oil Pay at 2183</u>		

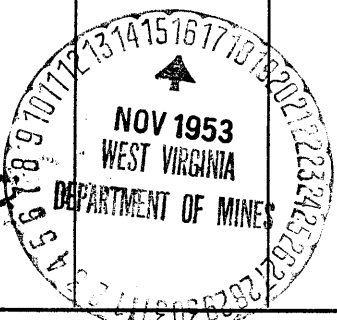

(Over)

MAY 10 1954

Formation	Color	Hard or Soft	Top	Bottom	Oil, Gas or Water	Depth Found	Remarks
							10

Date Nov. 9, 1953

APPROVED E. W. White, Owner

By Pantner
(Title)

WELL RECORD

1018A

Permit No. _____

Oil or Gas Well _____

Company Lackey & White

Address Raven Rock, West Va.

Farm H.F. Hudkins Acres 201

Location (waters) LEASOR RUN

Well No. 11 Elev. 1073

District Central County Doddridge

The surface of tract is owned in fee by H.F. Hudkins
Greenwood Address West Va.

Mineral rights are owned by Same

Drilling commenced 1917

Drilling completed _____

Date Shot _____ From _____ To _____

With _____

Open Flow /10th Water to _____ Inch
 /10th Steam to _____ Inch

Volume _____ Cu Ft

Rock Pressure _____ Psi

Oil Not Now Encountered Mch. to 60 lbs.

Fresh water _____ Gals

Salt water _____ Gals

Casing and Tubing	Used in Drilling	Left in Well	Packers
16			Kind of Packer
12			
10	240	none	Size of
8 1/2	1395	"	
6 1/2	2059	2059	Depth set
5 1/2	2086 ft. run		
4	1940 on hook		Perf. top
2	wall packer.		Perf. bottom
Line used	2189 2" tubing		Perf. top
			Perf. bottom

CASING CEMENTED _____ SIZE _____ No. Ft. _____ Date _____

COAL WAS ENCOUNTERED AT _____ FEET _____ INCHES

_____ FEET _____ INCHES FEET _____ INCHES

_____ FEET _____ INCHES FEET _____ INCHES

Formation	Color	Top of	Bottom	Oil, Gas or Water	Depth Found	Remarks
1st. calc sand		1895	1800			
2nd. Calc sand		1790	1800			
Massive sand		1590	2021			
Big lim		2080	2128			
Injan Sand		2128	2183			
		Bottom	2183			Oil Pay at 2183

017-31018

was 71239

25' loc. Penn 1080

2.615 30 1730

621 W80 5230

15' loc

5485

24000



AFFIDAVIT OF PLUGGING AND FILLING WELL

AFFIDAVIT SHOULD BE MADE IN TRIPPLICATE. ONE COPY MAILED TO THE DEPARTMENT ONE COPY TO BE BY WELL OPERATOR AND THE THIRD COPY (AND EXTRA COPIES IF REQUIRED) SHOULD BE MAILED TO EACH COAL OPERATOR AT THEIR ADDRESS.

COAL OPERATOR OR OWNER Lackey & White
 NAME OF WELL OPERATOR Raven Rock, W. Va.
 COMPLETE ADDRESS _____

COAL OPERATOR OR OWNER _____
 WELL AND LOCATION _____

COAL OPERATOR OR OWNER Lackey & White
 LEASE OR PROPERTY OWNER Same

WELL No. 11


H.F. Hudkins Farm

STATE INSPECTOR SUPERVISING PLUGGING Andrew K. Casto

AFFIDAVIT

STATE OF WEST VIRGINIA, }
 County of Pleasants } ss:
Walter Vickers and Don E. White
 being first duly sworn according to law depose and say that they are experienced in the work of plugging and filling oil and gas wells and were employed by Lackey & White, well operator, and participated in the work of plugging and filling the above well, that said work was commenced on the 14 day of NOV., 19 53, and that the well was plugged and filled in the following manner:

GANG OR INDEX RECORD	FILLING MATERIAL	PLUGS USED		CASING	
		ONE & ONE	ONE	ONE	ONE
		5 3/16	2086	None	
		6 5/8	1200	859	
	Pulled 5 3/16 casing.				
	Placed bridge at 2116 with 2 sacks cement and 5 ft. stone on bridge, then filled with clay to 20 89.				
	Parted pipe at 1200 ft.				
	Placed bridge on parted pipe and filled for 50 ft. with clay, 2 sacks cement and 5 ft. stone on fill.				
	Placed another bridge at 240, 2 sacks cement and 5 ft. stone on bridge, then filled to surface with clay.				
	Marker erected as described in rule 12, 1931 Regulations.				

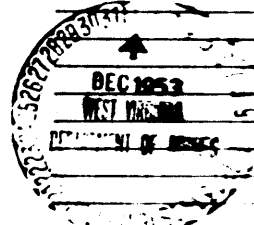

and that the work of plugging and filling said well was completed on the 25th day of November, 19 53

And further deponents saith not

Walter Vickers
Don E. White

Subscribed and sworn to before me this 30 day of Nov. 19 53