

New Location...
 Drill Deeper.....
 Abandonment.....

MAR - 8 1954

HUDKINS DOD-1022-A-#3
 DOD-1023-A-#3
 SMITH-SUMMERS

Company MACKAY AND WHITE
 Address RAVEN ROCK, W. VA.
 Farm ALFRED ADAMS
 Tract _____ Acres 108 Lease No. _____
 Well (Farm) No. 1, 3, 3, 4, 5 Serial No. _____
 Elevation (Spirit Level) 1016, 1031, 1150, 1127, 1204
 Quadrangle WEST UNION
 County DODDRIDGE District CENTRAL
 Engineer B. F. RINEHART
 Engineer's Registration No. 543
 File No. _____ Drawing No. _____
 Date 10-12-53 Scale 1" = 500'

STATE OF WEST VIRGINIA
 DEPARTMENT OF MINES
 OIL AND GAS DIVISION
 CHARLESTON
 DOD-1024-A-#5 - SMITH-SUMMERS
WELL LOCATION MAP
 FILE NO. DOD-1025-A-#1 S.A.
DOD-1026-A-#4 S.A.
 + Denotes location of well on United States Topographic Maps, scale 1 to 62,500, latitude and longitude lines being represented by border lines as shown.
 - Denotes one inch spaces on border line of original tracing.



STATE OF WEST VIRGINIA
DEPARTMENT OF MINES
OIL AND GAS DIVISION

954

West Union
1522A

WELL RECORD

Permit No. _____

Oil or Gas Well _____

(KIND)

Company Mackey & White
Address G/O Don E. White
St. Marys, West Va.
Farm Alfred Adams Acres 108
Location (waters) Greenwood Hill
Well No. 3 Elev. 1150
District Central County Doddridge
The surface of tract is owned in fee by Alfred Adams
Greenwood Address W. Va.
Mineral rights are owned by Smith Heirs
Greenwood Address W. Va.
Drilling commenced 1917
Drilling completed (Smith Heirs)
Date Shot _____ From _____ To _____
With _____


Casing and Tubing	Used in Drilling	Left in Well	Packers
Size			Kind of Packer
16			
12 <u>30"</u>	<u>264</u>	<u>none</u>	
10 <u>8"</u>	<u>1350</u>	<u>none</u>	Size of
8 <u>6 5/8"</u>	<u>2096</u>	<u>2096</u>	Depth set
6 5/8			
5 3/16	<u>5 inch in well no record of amount.</u>		Perf. top
3			Perf. bottom
2			Perf. top
Liners Used			Perf. bottom

Open Flow /10ths Water in _____ Inch
/10ths Merc. in _____ Inch
Volume _____ Cu. Ft.
Rock Pressure _____ lbs. _____ hrs.
Oil Now dry bbls., 1st 24 hrs.
Fresh water _____ feet _____ feet
Salt water _____ feet _____ feet

CASING CEMENTED _____ SIZE _____ No. Ft. _____ Date _____

COAL WAS ENCOUNTERED AT _____ FEET _____ INCHES
_____ FEET _____ INCHES _____ FEET _____ INCHES
_____ FEET _____ INCHES _____ FEET _____ INCHES

Formation	Color	Hard or Soft	Top	Bottom	Oil, Gas or Water	Depth Found	Remarks
<u>1st. Salt Sand</u>			<u>1680</u>	<u>1715</u>			
<u>Maxon Sand</u>			<u>2056</u>	<u>2061</u>			
<u>Big Lime</u>			<u>2080</u>	<u>2162</u>			
<u>Injun Sand</u>			<u>2162</u>	<u>2217</u>			
<u>Total Depth</u>			<u>2236</u>				
<p>Please note as shown by map that there are two #3 wells on Alfred Adams Farm. This being #3 on Smith hrs. lease.</p>							

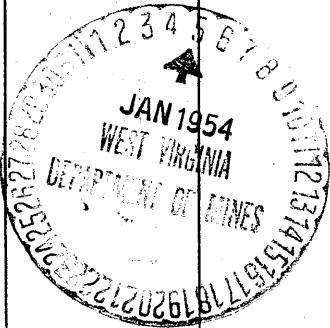

Formation	Color	Hard or Soft	Top	Bottom	Oil, Gas or Water	Depth Found	Remarks
							18



 HARRISVILLE
 LUG 14 1911

Date June 21, 1911

APPROVED Edward W. White, Owner

By _____ (Title)