

New Location
 Drill Deeper
 Abandonment 6-1-77

Company ELDON HAUGHT (Dept. of Mines & G.)
 Address Smithville, W. Va.
 Farm C. T. DARNELL
 Tract _____ Acres 30 Lease No. _____
 Well (Farm) No. 1 Serial No. _____
 Elevation (Spirit Level) 1150'
 Quadrangle WEST UNION SC
 County DODDRIDGE District CENTRAL
 Engineer Donald W. Morris
 SURVEYED BY J. F. DEEM
 Engineer's Registration No. 1653
 File No. _____ Drawing No. _____
 Date APRIL 17, 1954 Scale 1" = 300'

STATE OF WEST VIRGINIA
 DEPARTMENT OF MINES
 OIL AND GAS DIVISION
 CHARLESTON

WELL LOCATION MAP

FILE NO. DOD-1034-A

+ Denotes location of well on United States Topographic Maps, scale 1 to 62,500, latitude and longitude lines being represented by border lines as shown.

- Denotes one inch spaces on border line of original tracing.

47-017 JUL 19 1978

Latitude 39° 20'

DOTSON

Longitude 80° 50'

1

2

3

DARNELL

NO. 4

S 2° 00' W
578'

S 23° E
490'

HY.

GUM

N 65° 30' E 415'

STAKE

368'
S 45° 55' W

NO. 1 ELEV. 1150

C. T. DARNELL

30A



HUDKINS

New Location...
Drill Deeper.....
Abandonment.....



Company MACKEY & WHITE
 Address RAVEN ROCK, W. VA
 Farm C. T. DARNELL
 Tract _____ Acres 30 Lease No. _____
 Well (Farm) No. 1 Serial No. _____
 Elevation (Spirit Level) 1150'
 Quadrangle WEST UNION
 County DODDRIDGE District CENTRAL
 Engineer Donald W. Morris
 SURVEYED BY J. F. DEEM
 Engineer's Registration No. 1653
 File No. _____ Drawing No. _____
 Date APRIL 17, 1954 Scale 1" = 300'

STATE OF WEST VIRGINIA
DEPARTMENT OF MINES
OIL AND GAS DIVISION
CHARLESTON

WELL LOCATION MAP

FILE NO. DOD-1034-A

+ Denotes location of well on United States Topographic Maps, scale 1 to 62,500, latitude and longitude lines being represented by border lines as shown.

- Denotes one inch spaces on border line of original tracing.



STATE OF WEST VIRGINIA
DEPARTMENT OF MINES
OIL AND GAS DIVISION

977

Quadrangle 10944A

WELL RECORD

Permit No. _____

Oil or Gas Well _____ (KIND)


Company Maakey & White
 Address Raven Rock, W.Va.
 Farm O.T. Darnell Acres 30
 Location (waters) Greenwood hill
 Well No. 1 Elev. 1150
 District Central County Doddridge
 The surface of tract is owned in fee by O.T. Darnell
Greenwood, W.Va. Address _____
 Mineral rights are owned by same
 Address _____
 Drilling commenced 1916
 Drilling completed _____
 Date Shot From _____ To _____
 With _____
 Open Flow /10ths Water in _____ Inch
 /10ths Merc. in _____ Inch
 Volume _____ Cu. Ft.
 Rock Pressure _____ lbs. _____ hrs.
 Oil _____ bbls., 1st 24 hrs.
 Fresh water _____ feet _____ feet
 Salt water _____ feet _____ feet

Casing and Tubing	Used in Drilling	Left in Well	Packers
Size			
16			Kind of Packer
13			
10	385	none	Size of
8 1/4	1340	none	
6 5/8	2093	2093	Depth set
5 3/16	384 ft. set in on hook packer	set in wall	
3			Perf. top
2			Perf. bottom
Liners Used	2237 2" tubing		Perf. top
			Perf. bottom

CASING CEMENTED _____ SIZE _____ No. Ft. _____ Date _____
 COAL WAS ENCOUNTERED AT _____ FEET _____ INCHES
 _____ FEET _____ INCHES FEET _____ INCHES
 _____ FEET _____ INCHES FEET _____ INCHES

Formation	Color	Hard or Soft	Top	Bottom	Oil, Gas or Water	Depth Found	Remarks
1st. Salt Sand			1665	1685			
2 nd. "			1780	1800			
Maxon Sand			1990	2005			
Big Lime			2085	2181			
Injun sand			2181	2237. Total Depth		2237.	

9

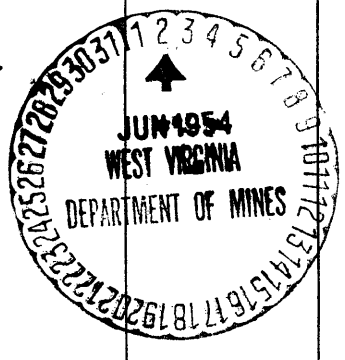

Formation	Color	Hard or Soft	Top	Bottom	Oil, Gas or Water	Depth Found	Remarks
							9

Date May 31, 1954

APPROVED: Low E. N. K., Owner

By Markus
(Title)