


Latitude 39° 15'

0.045
2.72 W

Longitude 80° 50'

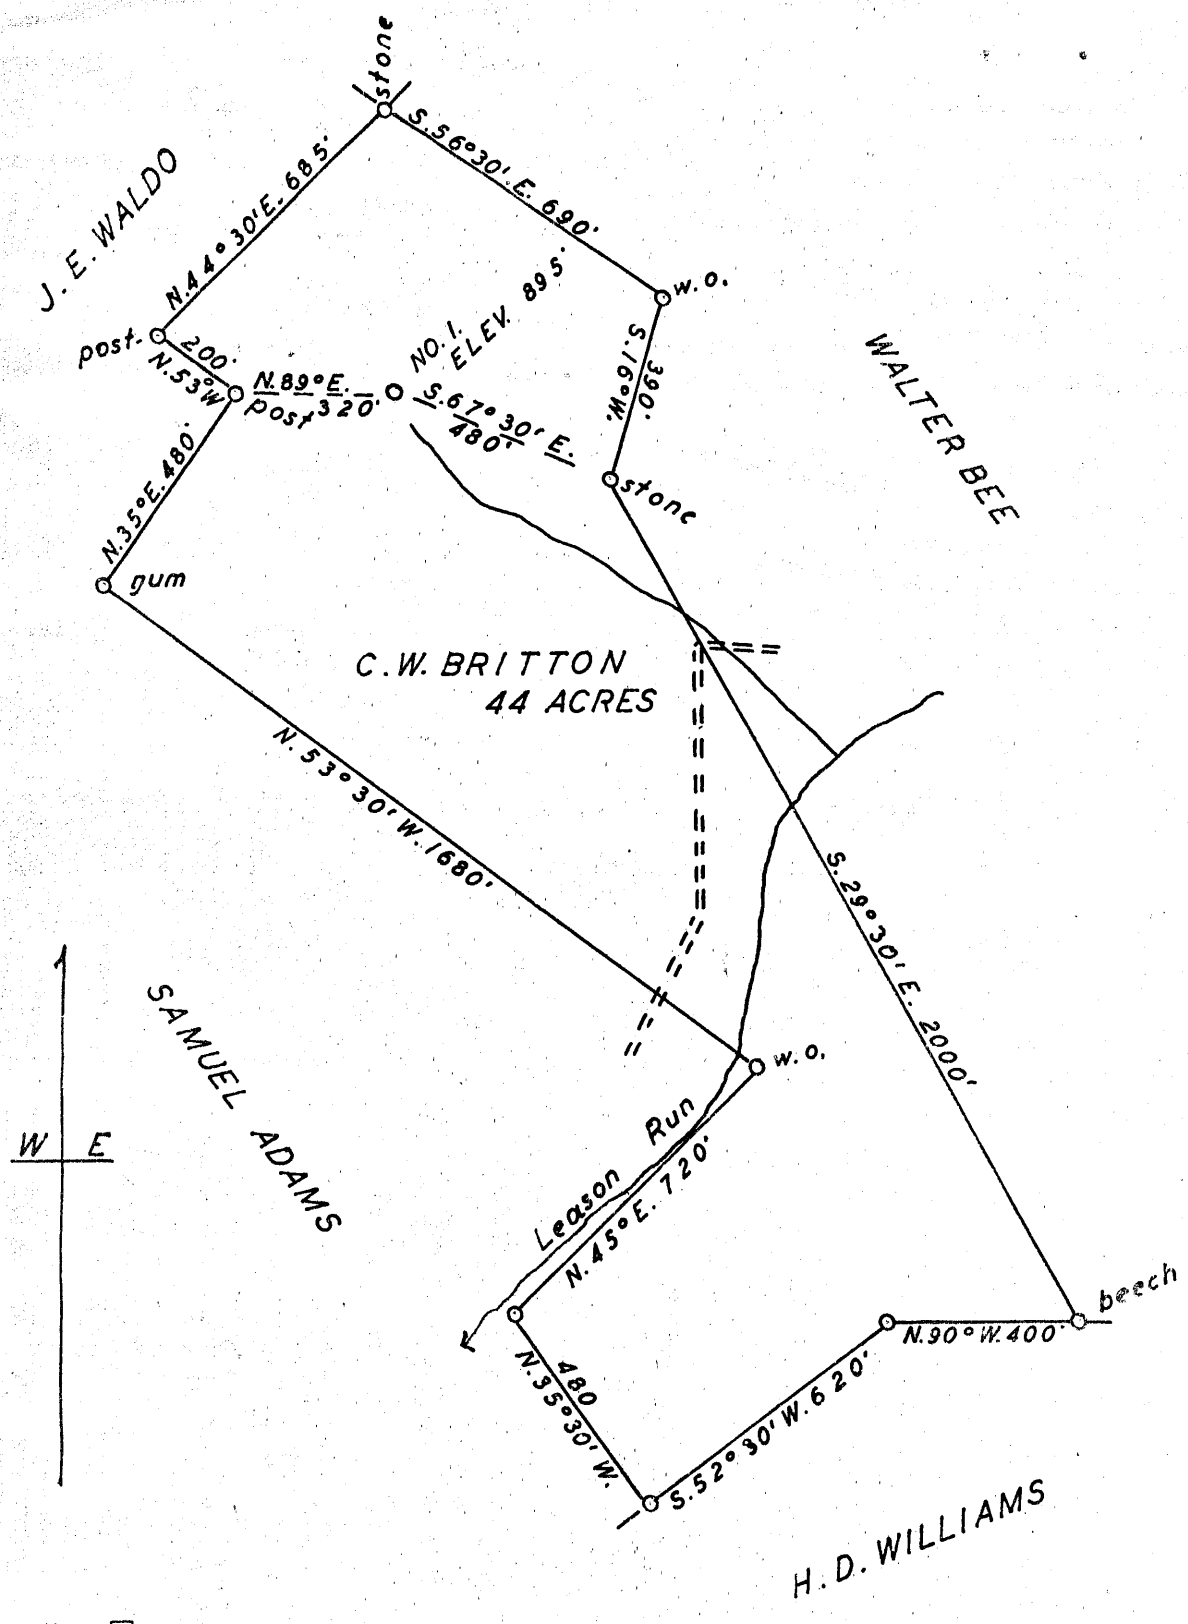

- New Location..
- Drill Deeper.....
- Abandonment.....

Company MACKAY & WHITE
 Address RAVEN ROCK. W.VA.
 Farm C.W. BRITTON
 Tract _____ Acres 44 Lease No. _____
 Well (Farm) No. 1 Serial No. 530
 Elevation (Spirit Level) 895'
 Quadrangle HOLBROOK
 County DODDRIDGE District CENTRAL
 Engineer George R. Bokar
 Surveyed by Homer W. Myers
 Engineer's Registration No. 102
 File No. _____ Drawing No. _____
 Date SEPT. 7, 1954 Scale 1" = 400'

STATE OF WEST VIRGINIA
 DEPARTMENT OF MINES
 OIL AND GAS DIVISION
 CHARLESTON

WELL LOCATION MAP

FILE NO. DOD-1042-A

+ Denotes location of well on United States Topographic Maps, scale 1 to 62,500, latitude and longitude lines being represented by border lines as shown.

- Denotes one inch spaces on border line of original tracing.



STATE OF WEST VIRGINIA
DEPARTMENT OF MINES
OIL AND GAS DIVISION

976

WELL RECORD

Permit No. 1040A


Oil or Gas Well _____
(KIND)

Company Mackey & White
Address Raven Rock, W.Va.
Farm C.W. Britton Acres 44
Location (waters) Loosen Run
Well No. 1 Elev 895
District Central County Doddridge
The surface of tract is owned in fee by C.W. Britton
Greenwood, W.Va. Address _____
Mineral rights are owned by Same
Address _____
Drilling commenced A
Drilling completed 1915
Date Shot _____ From _____ To _____
With _____
Open Flow _____ /10ths Water in _____ Inch
_____ /10ths Merc. in _____ Inch
Volume _____ Cu. Ft.
Rock Pressure _____ lbs. _____ hrs.
Oil _____ bbls., 1st 24 hrs.
Fresh water _____ feet _____ feet
Salt water _____ feet _____ feet

Casing and Tubing	Used in Drilling	Left in Well	Packers
Size			
16			Kind of Packer
13			
10	262	262	Size of
8 1/4	1,138	1,138	
6 5/8	1,866	1,866	Depth set
5 3/16	1,881	1,881	
3	5" Run on packer after well comp.		Perf. top
2			Perf. bottom
Liners Used	1,959 2" Tubing		Perf. top
			Perf. bottom

CASING CEMENTED _____ SIZE _____ No. Ft. _____ Date _____
COAL WAS ENCOUNTERED AT _____ FEET _____ INCHES
_____ FEET _____ INCHES FEET _____ INCHES
_____ FEET _____ INCHES FEET _____ INCHES

Formation	Color	Hard or Soft	Top	Bottom	Oil, Gas or Water	Depth Found	Remarks
1st. Salt Sand			1380	1415			
2nd. Salt Sand			1425	1480			
Maxon Sand			1790	1812			
Big Line			1855	1927			
Big Injun			1927				
			Bottom Hole	1967	Oil & Gas	1935 1945	

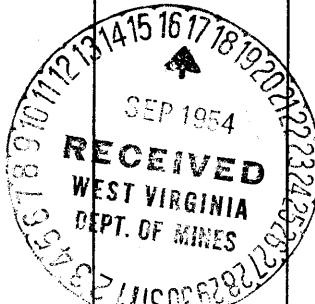

(Over)

NOV 12 1954

