

- New Location..
- Drill Deeper.....
- Abandonment.....

Company Mackey & White

Address Raven Rock, W. Va.

Farm J.N. Underwood

Tract \_\_\_\_\_ Acres 400 Lease No. \_\_\_\_\_

Well (Farm) No. 3 Serial No. \_\_\_\_\_

Elevation (Spirit Level) 900'

Quadrangle Centerpoint

County Doddridge District McClellan

Engineer Robert R. Anderson

By Jno. Triplett, Surveyor

Engineer's Registration No. 296

File No. \_\_\_\_\_ Drawing No. \_\_\_\_\_

Date July 6, 1956 Scale 1" = 50 F.

STATE OF WEST VIRGINIA  
 DEPARTMENT OF MINES  
 OIL AND GAS DIVISION  
 CHARLESTON

**WELL LOCATION MAP**  
 FILE NO. DOD-1065-A

- + Denotes location of well on United States Topographic Maps, scale 1 to 62,500, latitude and longitude lines being represented by border lines as shown.
- Denotes one inch spaces on border line of original tracing.



STATE OF WEST VIRGINIA  
DEPARTMENT OF MINES  
OIL AND GAS DIVISION

1013

## WELL RECORD

Permit No. \_\_\_\_\_

Oil or Gas Well \_\_\_\_\_ (KIND)

Company Mackey & White  
 Address Raven Rock, W.Va.  
 Farm I.N. Underwood Acres 400  
 Location (waters) McElroy Creek  
 Well No. \_\_\_\_\_ Elev. 900  
 District McClellan<sup>3</sup> County Doddridge  
 The surface of tract is owned in fee by I.N. Underwood  
Sistersville Address W.Va.  
 Mineral rights are owned by Same  
 Address \_\_\_\_\_  
 Drilling commenced 1898  
 Drilling completed \_\_\_\_\_  
 Date Shot \_\_\_\_\_ From \_\_\_\_\_ To \_\_\_\_\_  
 With \_\_\_\_\_  
 Open Flow \_\_\_\_\_ /10ths Water in \_\_\_\_\_ Inch  
 \_\_\_\_\_ /10ths Merc. in \_\_\_\_\_ Inch  
 Volume \_\_\_\_\_ Cu. Ft.  
 Rock Pressure \_\_\_\_\_ lbs. \_\_\_\_\_ hrs.  
 Oil Now dry \_\_\_\_\_ bbls., 1st 24 hrs.  
 Fresh water \_\_\_\_\_ feet \_\_\_\_\_ feet  
 Salt water \_\_\_\_\_ feet \_\_\_\_\_ feet

Casing and Tubing	Used in Drilling	Left in Well	Packers
Size			Kind of Packer
16			
13			
10	113	113	Size of
8 1/4	1416	pulled	Depth set
6%	2204	2204	
5 3/16			
3			Perf. top
2			Perf. bottom
Liners Used	Tubing pulled		Perf. top
			Perf. bottom


CASING CEMENTED \_\_\_\_\_ SIZE \_\_\_\_\_ No. Ft. \_\_\_\_\_ Date \_\_\_\_\_

COAL WAS ENCOUNTERED AT \_\_\_\_\_ FEET \_\_\_\_\_ INCHES

\_\_\_\_\_ FEET \_\_\_\_\_ INCHES \_\_\_\_\_ FEET \_\_\_\_\_ INCHES

\_\_\_\_\_ FEET \_\_\_\_\_ INCHES \_\_\_\_\_ FEET \_\_\_\_\_ INCHES

Formation	Color	Hard or Soft	Top	Bottom	Oil, Gas or Water	Depth Found	Remarks
			2218		C		
			2310				
			All of record available.				

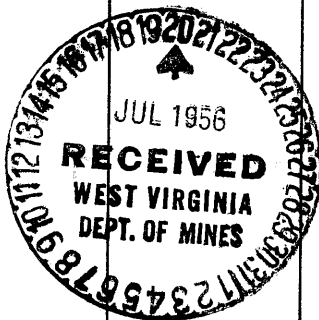

Formation	Color	Hard or Soft	Top	Bottom	Oil, Gas or Water	Depth Found	Remarks

Date July 17, 1956

APPROVED Dave White, Owner

By Partner  
(Title)