

Latitude 39° 25'

Longitude 80° 35'

+ 2.64S  
3.88W

A.C. BALLOUZ

RUTH SHRADER

JAMES D. FOLEY  
50<sup>ac</sup>

A.I. ALLEN

WM. RANDOLPH

HOMER WEEKLEY

L.M. ALLEN

7.5' loc - loc 9/24/58  
2.65S 39 25  
1.57W 80 3730  
calc 15' loc  
2.65S  
3.80W

- New Location ..
- Drill Deeper ..
- Abandonment ..

|                             |                              |
|-----------------------------|------------------------------|
| Company                     | WILLIAM CASSADY              |
| Address                     | CLARKSBURG, W.VA.            |
| Farm                        | JAMES D. FOLEY               |
| Tract                       | Acres 50 Lease No.           |
| Well (Farm) No.             | 1278 Serial No.              |
| Elevation (Spirit Level)    | 1205' VA                     |
| Quadrangle                  | CENTERPOINT NW 4             |
| County                      | DODDRIDGE District M'CLELLAN |
| Engineer                    | J.D. Jeffries                |
| Engineer's Registration No. | 1084                         |
| File No.                    | 191-8 Drawing No.            |
| Date                        | 4-22-57 Scale 1" = 500'      |

STATE OF WEST VIRGINIA  
DEPARTMENT OF MINES  
OIL AND GAS DIVISION  
CHARLESTON

### WELL LOCATION MAP

FILE NO. DOD-1071-B

+ Denotes location of well on United States Topographic Maps, scale 1 to 62,500, latitude and longitude lines being represented by border lines as shown.

- Denotes one inch spaces on border line of original tracing.



1017

STATE OF WEST VIRGINIA  
DEPARTMENT OF MINES  
OIL AND GAS DIVISION

WELL RECORD

Quadrangle Centerpoint  
Permit No. Ab Ddd-1071-A


Oil or Gas Well X (KIND)

Company William Cassady (J. P. Droppleman)  
 Address 254 1/2 Haymond Highway - Clarksburg, W. Va.  
 Farm W. B. Foley (James & Foley) Plot 50 Acres  
 Location (waters) \_\_\_\_\_  
 Well No. 1278 Elev. 1205 1/4  
 District McClellan County Doddridge  
 The surface of tract is owned in fee by \_\_\_\_\_  
 Address \_\_\_\_\_  
 Mineral rights are owned by \_\_\_\_\_  
 Address \_\_\_\_\_  
 Drilling commenced 7/18/16  
 Drilling completed \_\_\_\_\_  
 Date Shot \_\_\_\_\_ From \_\_\_\_\_ To \_\_\_\_\_  
 With \_\_\_\_\_  
 Open Flow \_\_\_\_\_ /10ths Water in \_\_\_\_\_ Inch  
 \_\_\_\_\_ /10ths Merc. in \_\_\_\_\_ Inch  
 Volume \_\_\_\_\_ Cu. Ft.  
 Rock Pressure \_\_\_\_\_ lbs. \_\_\_\_\_ hrs.  
 Oil \_\_\_\_\_ bbls., 1st 24 hrs.  
 Fresh water \_\_\_\_\_ feet \_\_\_\_\_ feet  
 Salt water \_\_\_\_\_ feet \_\_\_\_\_ feet

| Casing and Tubing | Used in Drilling | Left in Well | Packers        |
|-------------------|------------------|--------------|----------------|
| Size              |                  |              | Kind of Packer |
| 13                |                  |              |                |
| 10                |                  |              | Size of        |
| 8 1/4             |                  |              |                |
| 6 1/2             | 2209'            | 2269'        | Depth set      |
| 5 3/16            |                  |              |                |
| 3                 |                  |              | Perf. top      |
| 2                 | 2358'            | 2358'        | Perf. bottom   |
| Liners Used       |                  |              | Perf. top      |
|                   |                  |              | Perf. bottom   |

CASING CEMENTED \_\_\_\_\_ SIZE \_\_\_\_\_ No. Ft. \_\_\_\_\_ Date \_\_\_\_\_  
 COAL WAS ENCOUNTERED AT \_\_\_\_\_ FEET \_\_\_\_\_ INCHES  
 \_\_\_\_\_ FEET \_\_\_\_\_ INCHES FEET \_\_\_\_\_ INCHES  
 \_\_\_\_\_ FEET \_\_\_\_\_ INCHES FEET \_\_\_\_\_ INCHES

| Formation       | Color | Hard or Soft | Top  | Bottom | Oil, Gas or Water | Depth Found | Remarks |
|-----------------|-------|--------------|------|--------|-------------------|-------------|---------|
| Pittsburgh Coal |       |              | 81.0 | 81.6   | C                 |             |         |
| Red Rock        |       |              | 84.6 | 1210   |                   |             |         |
| First Cow Run   |       |              | 1210 | 1233   |                   |             |         |
| Second Cow Run  |       |              | 1320 | 1340   |                   |             |         |
| 1st Salt Sand   |       |              | 1440 | 1600   |                   |             |         |
| 2nd Salt Sand   |       |              | 1600 | 1660   |                   |             |         |
| 3rd Salt Sand   |       |              | 1660 | 1910   |                   |             |         |
| Maxton Sand     |       |              | 1975 | 1995   |                   |             |         |
| Little Lime     |       |              | 1995 | 2175   |                   |             |         |
| Big Lime        |       |              | 2175 | 2268   |                   |             |         |
| Big Injun       |       |              | 2268 | 2368   |                   |             |         |
| Total Depth     |       |              |      | 2368   |                   |             |         |

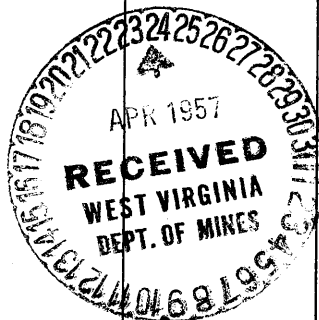

JUN 20 1957