

New Location ..
 Drill Deeper
 Abandonment

Company	WILLIAM CASSADY
Address	CLARKSBURG, W.VA.
Farm	A. I. ALLEN
Tract	Acres 60 Lease No. _____
Well (Farm) No.	189 Serial No. _____
Elevation (Spirit Level)	1188' VA.
Quadrangle	CENTERPOINT NW 4
County	DODDRIDGE District M ^c CLELLAN
Engineer	J. D. Jeffries
Engineer's Registration No.	1084
File No.	191-8 Drawing No. _____
Date	4-22-57 Scale 1" = 500'

STATE OF WEST VIRGINIA
 DEPARTMENT OF MINES
 OIL AND GAS DIVISION
 CHARLESTON

WELL LOCATION MAP
 FILE NO. DOD-1072-A

+ Denotes location of well on United States Topographic Maps, scale 1 to 62,500, latitude and longitude lines being represented by border lines as shown.

- Denotes one inch spaces on border line of original tracing.

R.D.M.^c



1042

STATE OF WEST VIRGINIA
DEPARTMENT OF MINES
OIL AND GAS DIVISION

Center point
Quadrangle

WELL RECORD

Oil or Gas Well _____
(KIND)

Permit No. 1072-A

Company William Cassidy
Address 25 1/2 Haymond Highway - Clarksburg,
Farm A. I. Allen Acres 60

Location (waters) _____
Well No. 189 Elev. 1188'
District McClellan County Doddridge

The surface of tract is owned in fee by _____
Address _____

Mineral rights are owned by _____
Address _____

Drilling commenced April 8, 1916

Drilling completed _____

Date Shot _____ From 2 205 To 2 3 13

With _____

Open Flow _____ /10ths Water in _____ Inch

_____ /10ths Merc. in _____ Inch

Volume _____ Cu. Ft.

Rock Pressure _____ lbs. _____ hrs.

Oil _____ bbls., 1st 24 hrs.

WELL ACIDIZED _____

WELL FRACTURED _____

RESULT AFTER TREATMENT _____

ROCK PRESSURE AFTER TREATMENT _____

Fresh Water _____ Feet

Casing and Tubing	Used in Drilling	Left in Well	Packers
Size			Kind of Packer
16			
13			
10			Size of
8 1/4	1621'	1621'	
6 5/8	2160'	2160'	Depth set
5 3/16			
3			Perf. top
2	2332'	2332'	Perf. bottom
Liners Used			Perf. top
			Perf. bottom


CASING CEMENTED _____ SIZE _____ No. Ft. _____ Date _____

COAL WAS ENCOUNTERED AT _____ FEET _____ INCHES

_____ FEET _____ INCHES _____ FEET _____ INCHES

_____ FEET _____ INCHES _____ FEET _____ INCHES

Formation	Color	Hard or Soft	Top	Bottom	Oil, Gas or Water	Depth	Remarks
Pittsburgh Coal			815	818	(Circled)		
Little Dunkard			1190	1202			
Big Dunkard			1350	1360			
Gas Sand			1425	1485			
First Salt Sand			1515	1550			
2nd Salt Sand			1600	1650			
Maxon Sand			1868	1980			
Little Lime			2100	2120			
Pencil Cave			2185	2321 2120 - 2125			
Big Injun			2185	2321			
Total Depth				2321			

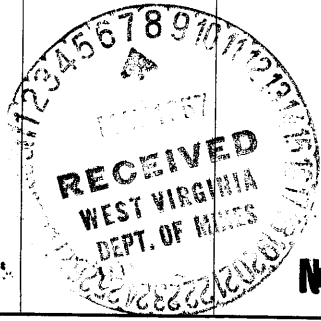

NOV 5 1959