

Company A. M. SNIDER (FRED FINCH)
 Address HUNDRED, W. VA.
 Farm GAY FREEMAN
 Tract _____ Acres 137 Lease No. _____
 Well (Farm) No. 1 Serial No. 3623
 Elevation (Spirit Level) 1190'
 Quadrangle VADIS DE
 County DODDRIDGE District GREENBRIER
 Engineer JOHN W. HAMILTON
 Engineer's Registration No. 2274
 File No. _____ Drawing No. _____
 Date JAN. 18, 1958 Scale 1" = 40 POLES

STATE OF WEST VIRGINIA
 DEPARTMENT OF MINES
 OIL AND GAS DIVISION
 CHARLESTON

WELL LOCATION MAP
 FILE NO. DOD-1080-B

+ Denotes location of well on United States Topographic Maps, scale 1 to 62,500, latitude and longitude lines being represented by border lines as shown.

- Denotes one inch spaces on border line of original tracing.



1078

STATE OF WEST VIRGINIA
DEPARTMENT OF MINES
OIL AND GAS DIVISION

Quadrangle Vicksburg

WELL RECORD

Permit No. 1080-A

Oil or Gas Well (KIND)

Company A. M. Snider
Address Hundred, West Virginia
Farm Gay Freeman Acres 137
Location (waters) (D)
Well No. 3623 Elev 1190'
District Greenbrier County Doddridge
The surface of tract is owned in fee by _____
Address _____
Mineral rights are owned by _____
Address _____


Casing and Tubing	Used in Drilling	Left in Well	Packers
Size			Kind of Packer
16			
13			
10	<u>361</u>	<u>Pulled</u>	Size of
8 1/4	<u>1208</u>	<u>Left in</u>	
6 5/8	<u>2158</u>	<u>Left in</u>	Depth set
5 3/16	<u>2722</u>	<u>Left in</u>	
3			Perf. top
2			Perf. bottom
Liners Used			Perf. top
			Perf. bottom

Drilling commenced _____
Drilling completed _____
Date Shot _____ From _____ To _____
With _____

Open Flow _____ /10ths Water in _____ Inch
_____ /10ths Merc. in _____ Inch
Volume _____ Cu. Ft.
Rock Pressure _____ lbs. _____ hrs.
Oil _____ bbls., 1st 24 hrs.
Fresh water _____ feet _____ feet
Salt water _____ feet _____ feet

CASING CEMENTED _____ SIZE _____ No. Ft. _____ Date _____
COAL WAS ENCOUNTERED AT 724 FEET _____ INCHES
_____ FEET _____ INCHES FEET _____ INCHES
_____ FEET _____ INCHES FEET _____ INCHES

Formation	Color	Hard or Soft	Top	Bottom	Oil, Gas or Water	Depth Found	Remarks
<u>Pgh. Coal</u>			<u>724</u>	<u>730</u>			
<u>Dunkard Sand</u>			<u>1120</u>	<u>1215</u>			
<u>Salt Sand</u>			<u>1415</u>	<u>1810</u>			
<u>Maxon Sand</u>			<u>1963</u>	<u>1978</u>			
<u>Injun Sand</u>			<u>2140</u>	<u>2255</u>	<u>Gas 2160</u>		
<u>Fifty Foot Sand</u>			<u>2479</u>	<u>2498</u>			
<u>Thirty Foot Sand</u>			<u>2689</u>	<u>2708</u>			
<u>Stray Sand</u>			<u>2765</u>	<u>2790</u>	<u>Gas 2767</u>		
<u>Gordon Sand</u>			<u>2795</u>	<u>2818</u>	<u>Gas 2816</u>		
<u>Total Depth 3147'</u>							
<u>Filled up to 2871'</u>							

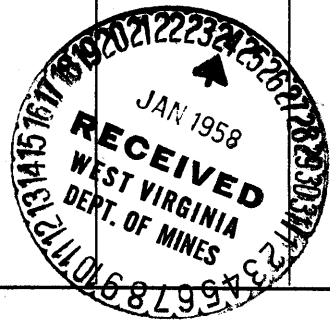

DEC 20 1958

(Over)