


Latitude 39 15

Longitude 80 45

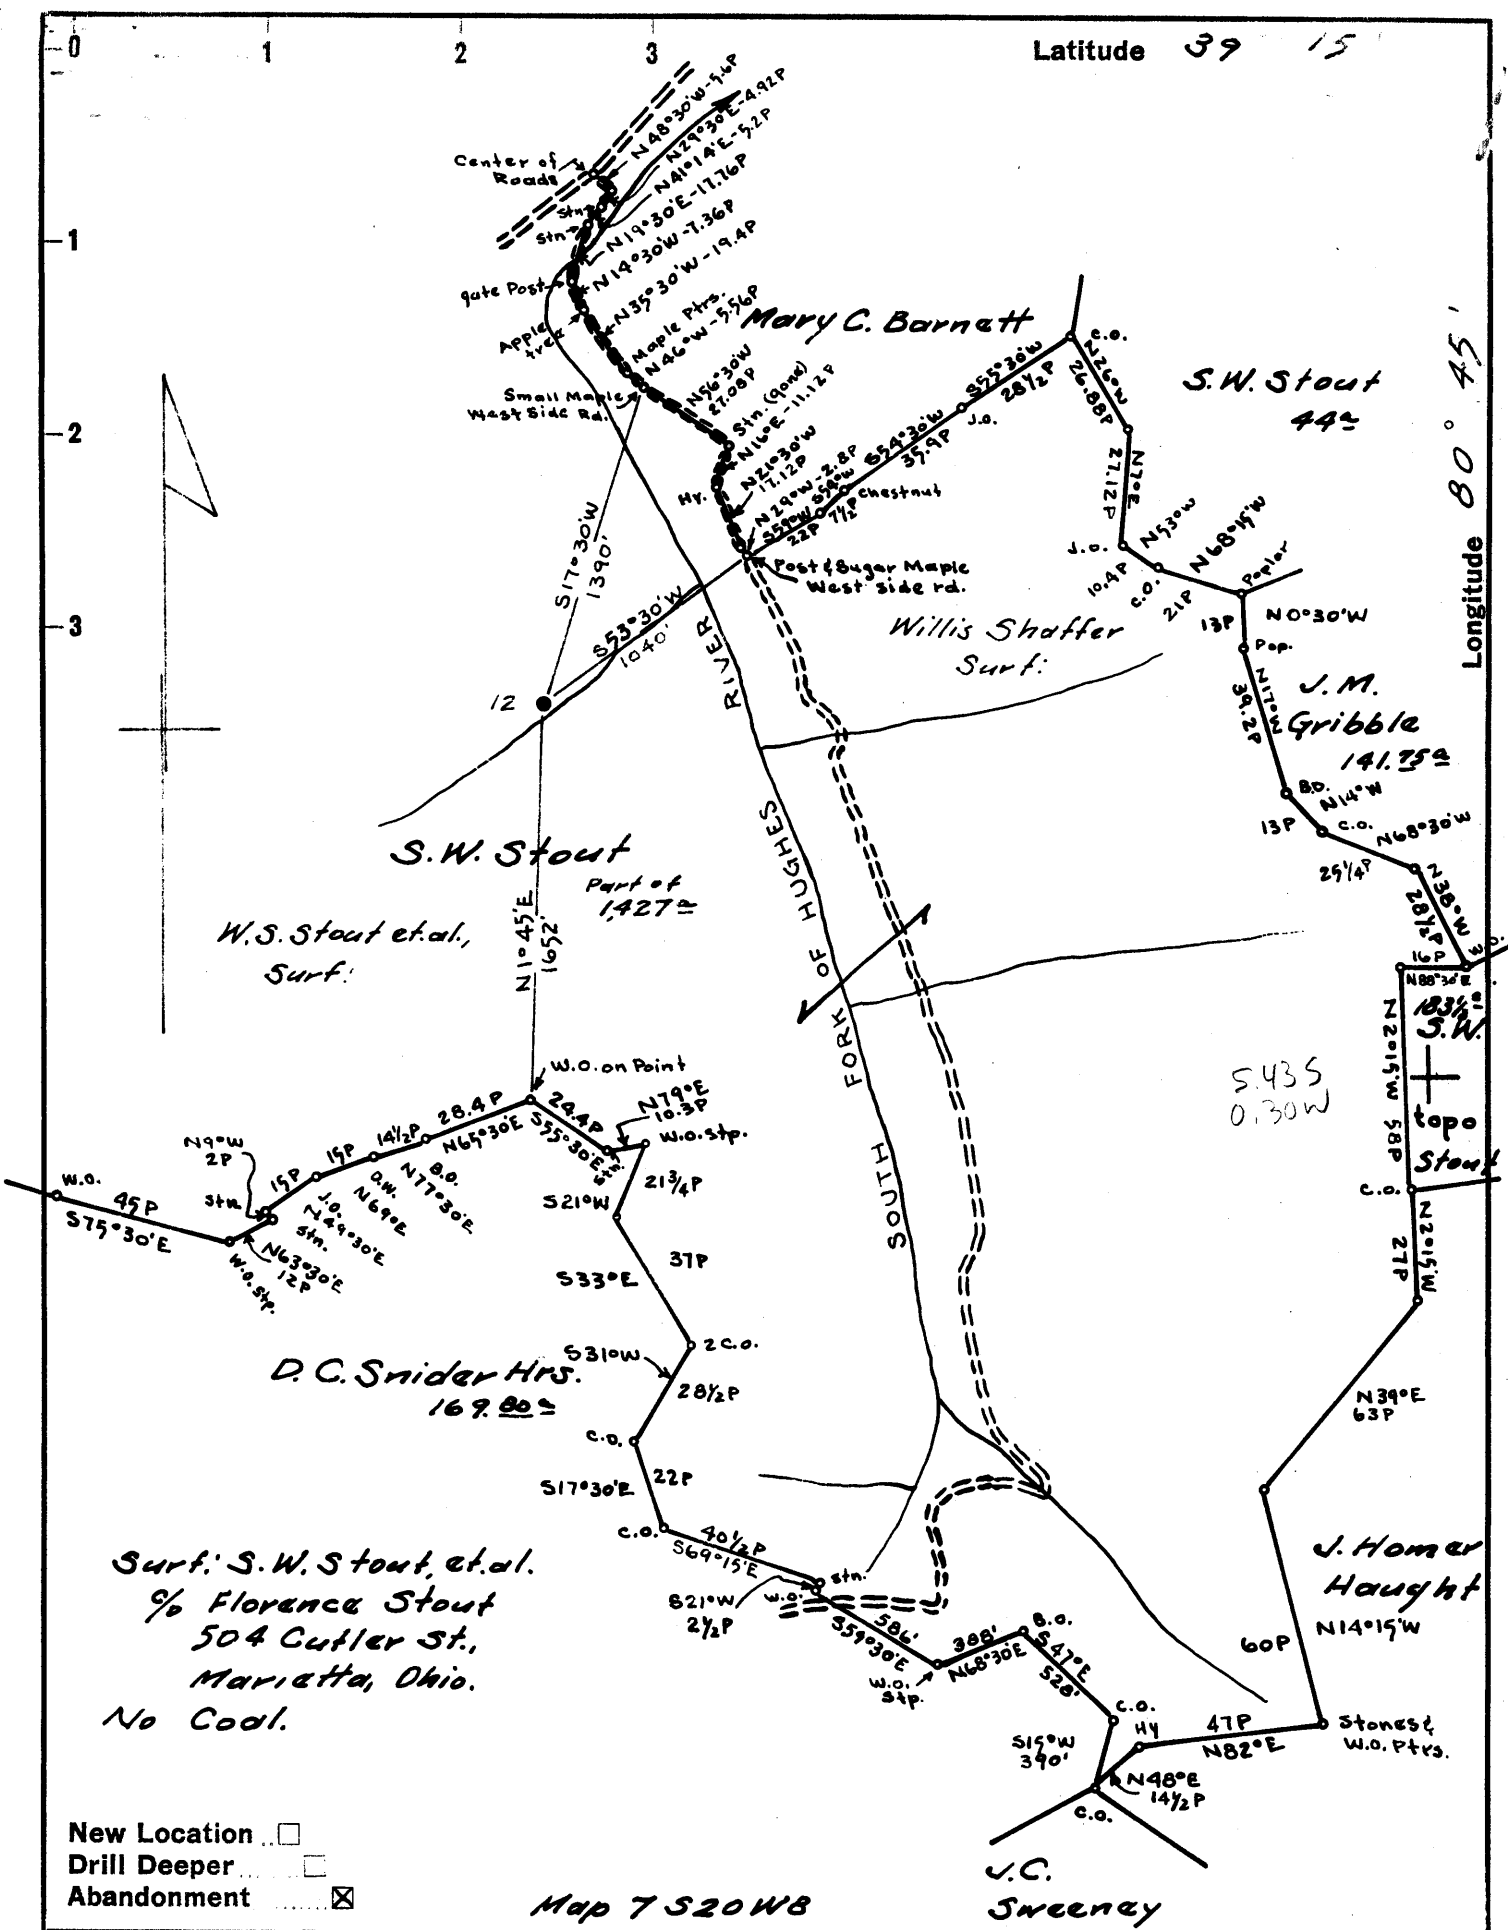

Company South Penn Natural Gas Co.
 Address Parkersburg, W. Va.
 Farm S.W. Stout
 Tract _____ Acres 1,427 Lease No. 80793
 Well (Farm) No. 12 Serial No. _____
 Elevation (Spirit Level) 988.01 floor
 Quadrangle Holbrook
 County Doddridge District Southwest
 Engineer A.C. Hillert
 Engineer's Registration No. 2534
 File No. 913 Drawing No. _____
 Date July 30, 1959 Scale 1" = 800'

STATE OF WEST VIRGINIA
 DEPARTMENT OF MINES
 OIL AND GAS DIVISION
 CHARLESTON

WELL LOCATION MAP
 FILE NO. DOD-1101-A.

+ Denotes location of well on United States Topographic Maps, scale 1 to 62,500, latitude and longitude lines being represented by border lines as shown.

- Denotes one inch spaces on border line of original tracing.



1058

STATE OF WEST VIRGINIA
DEPARTMENT OF MINES
OIL AND GAS DIVISION

Quadrangle Holbrook
Permit No. 1101-A

WELL RECORD

Oil or Gas Well _____
(KIND)

Company SOUTH PENN NATURAL GAS COMPANY
 Address P. O. Box 1280, Parkersburg, W. Va.
 Farm S. W. Stout Acres 1.27
 Location (waters) _____
 Well No. 12 Elev. 1788.0'
 District Southwest County Doddridge
 The surface of tract is owned in fee by _____
 Address _____
 Mineral rights are owned by Florence Stout, et al.
504 Cutler Street Address Marietta, Ohio
 Drilling commenced Nov. 7, 1899
 Drilling completed Jan. 21, 1900
 Date Shot 4 Times From _____ To _____
 With _____
 Open Flow /10ths Water in _____ Inch
 /10ths Merc. in _____ Inch
 Volume _____ Cu. Ft.
 Rock Pressure _____ lbs. _____ hrs.
 Oil _____ bbls., 1st 24 hrs.
 WELL ACIDIZED _____
 WELL FRACTURED _____

Casing and Tubing	Used in Drilling	Left in Well	Packers
Size			Kind of Packer _____
16			
13			
10	390	390-7	Size of _____
8 1/4			
6 5/8	1725'	1725'	Depth set _____
5 3/16			
3			Perf. top _____
2			Perf. bottom _____
Liners Used			Perf. top _____
			Perf. bottom _____

CASING CEMENTED _____ SIZE _____ No. Ft. _____ Date _____

COAL WAS ENCOUNTERED AT _____ FEET _____ INCHES
 _____ FEET _____ INCHES FEET _____ INCHES
 _____ FEET _____ INCHES FEET _____ INCHES

RESULT AFTER TREATMENT _____

ROCK PRESSURE AFTER TREATMENT _____

Fresh Water _____ Feet Salt Water _____ Feet

Formation	Color	Hard or Soft	Top	Bottom	Oil, Gas or Water	Depth	Remarks
Red Rock			800	1000			
First Cow Run Sand			1050	1090			
Salt Sand			1350	1500			
Maxton Sand			1645	1670			
Big Linc			1725	1815			
Injun			1815	1975	Oil Show	1825	
Gorden Stray			2503	2513			
Gorden			2523	2528	Oil	2523	
TOTAL DEPTH				2546			



NOV 5 1959

(over)

Formation	Color	Hard or Soft	Top	Bottom	Oil, Gas or Water	Depth Found	Remarks

Date July 27, 1959, 19__

APPROVE SOUTH FERN NATURAL GAS COMPANY, Owner

By George W. Wilman
 George W. Wilman, (Title) Land Agent