

Company LURAY LAND, INC.

Address POINT PLEASANT, WEST VA.

Farm J.W. SMITH

Tract \_\_\_\_\_ Acres 486 Lease No. \_\_\_\_\_

Well (Farm) No. 1 Serial No. 7071

Elevation (Spirit Level) 1294'

Quadrangle HOLBROOK

County DODDRIDGE District WEST UNION

Engineer H. P. SUTER

Engineer's Registration No. 1805

File No. \_\_\_\_\_ Drawing No. \_\_\_\_\_

Date 3 AUG. 1959 Scale 1" = 50 FEET

STATE OF WEST VIRGINIA  
DEPARTMENT OF MINES  
OIL AND GAS DIVISION  
CHARLESTON

**WELL LOCATION MAP**

FILE NO. DOD-1122-B

+ Denotes location of well on United States Topographic Maps, scale 1 to 62,500, latitude and longitude lines being represented by border lines as shown.

- Denotes one inch spaces on border line of original tracing.



1080

STATE OF WEST VIRGINIA  
DEPARTMENT OF MINES  
OIL AND GAS DIVISION

Quadrangle Halbrook  
Permit No. 1122-A

WELL RECORD

Oil or Gas Well \_\_\_\_\_ (KIND)

Company Hope Natural Gas Company  
Address Clarksburg, West Virginia  
Farm J. W. Smith Acres 486  
Location (waters) \_\_\_\_\_  
Well No. 7071 (H) Elev. 1234  
District West Union County Doddridge  
The surface of tract is owned in fee by \_\_\_\_\_  
Address \_\_\_\_\_  
Mineral rights are owned by \_\_\_\_\_  
Address \_\_\_\_\_  
Drilling commenced 5-15-23  
Drilling completed 6-29-23  
Date Shot \_\_\_\_\_ From \_\_\_\_\_ To \_\_\_\_\_  
With \_\_\_\_\_  
Open Flow \_\_\_\_\_ /10ths Water in \_\_\_\_\_ Inch  
\_\_\_\_\_ /10ths Merc. in \_\_\_\_\_ Inch  
Volume \_\_\_\_\_ Cu. Ft.  
Rock Pressure \_\_\_\_\_ lbs. \_\_\_\_\_ hrs.  
Oil \_\_\_\_\_ bbls., 1st 24 hrs.  
WELL ACIDIZED \_\_\_\_\_  
WELL FRACTURED \_\_\_\_\_

Casing and Tubing	Used in Drilling	Left in Well	Packers
Size			Kind of Packer _____
16			Size of _____
13			Depth set _____
10	480	Pulled	Perf. top _____
8 1/4	1140	Pulled	Perf. bottom _____
6 3/8	1972	1972	Perf. top _____
5 3/16			Perf. bottom _____
* 2	2137	Pulled	
2	2167'4"	2167'4"	
Liners Used			


CASING CEMENTED \_\_\_\_\_ SIZE \_\_\_\_\_ No. Ft. \_\_\_\_\_ Date \_\_\_\_\_

COAL WAS ENCOUNTERED AT \_\_\_\_\_ FEET \_\_\_\_\_ INCHES  
\_\_\_\_\_ FEET \_\_\_\_\_ INCHES FEET \_\_\_\_\_ INCHES  
\_\_\_\_\_ FEET \_\_\_\_\_ INCHES FEET \_\_\_\_\_ INCHES

RESULT AFTER TREATMENT \_\_\_\_\_  
ROCK PRESSURE AFTER TREATMENT \_\_\_\_\_  
Fresh Water \_\_\_\_\_ Feet Salt Water \_\_\_\_\_ Feet

Formation	Color	Hard or Soft	Top	Bottom	Oil, Gas or Water	Depth	Remarks
Cow Run (First)			905	975			
Cow Run (Second)			1035	1065			
Salt Sand (Upper)			1425	1510			
Salt Sand (Middle)			1545	1640			
Salt Sand (Lower)			1780	1830			
Maxon			1905	1930			
Little Lime			1935	1960			
Pencil Cave			1960	1965			
Big Lime			1965	2055			
Injun Sand			2055	2140	Gas at	2059-64 2135-40	
Total Depth				2147			

MAR 26 1960

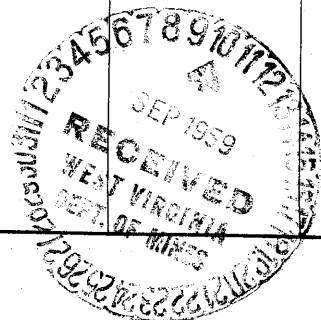

Formation	Color	Hard or Soft	Top	Bottom	Oil, Gas or Water	Depth Found	Remarks

Date **May 29,** , 19 **59**

APPROVED **LuRay Land, Inc.,** Owner  
 By *Byron M. Finch*  
**Byron M. Finch** (Title) **Consultant**