

Company FINCH AND SNIDER
 Address 56 TRAUGH AVE. - SALEM, W. VA.
 Farm MARTHA J. SMITH HRS.
 Tract _____ Acres 14 Lease No. _____
 Well (Farm) No. 5 Serial No. _____
 Elevation (Spirit Level) 927'
 Quadrangle CENTERPOINT
 County DODDRIDGE District MCCLELLAN
 Engineer JOHN W. HAMILTON
 Engineer's Registration No. 2274
 File No. _____ Drawing No. _____
 Date SEPT. 23, 1959 Scale 1" = 10 POLES

STATE OF WEST VIRGINIA
 DEPARTMENT OF MINES
OIL AND GAS DIVISION
 CHARLESTON

WELL LOCATION MAP
 FILE NO. DOD-1126-A

+ Denotes location of well on United States Topographic Maps, scale 1 to 62,500, latitude and longitude lines being represented by border lines as shown.

- Denotes one inch spaces on border line of original tracing.



1081

STATE OF WEST VIRGINIA
DEPARTMENT OF MINES
OIL AND GAS DIVISION

Quadrangle Centerpoint
Permit No. 1126 A

WELL RECORD

Oil or Gas Well Oil
(KIND)

Company Wilhelm & Jackson, Inc.
Address 614 E. Main St. Clarksburg, W. Va.
Farm Martha J. Smith Acres 14
Location (waters) _____
Well No. # 5 Elev. 427
District McClellan County Doddridge
The surface of tract is owned in fee by Martha J. Smith
Address Centerpoint, W. Va.
Mineral rights are owned by _____
Address _____
Drilling commenced N. R.
Drilling completed _____
Date Shot _____ From _____ To _____
With _____
Open Flow /10ths Water in _____ Inch
/10ths Merc. in _____ Inch
Volume _____ Cu. Ft.
Rock Pressure _____ lbs. _____ hrs.
Oil _____ bbls., 1st 24 hrs.
WELL ACIDIZED _____
WELL FRACTURED _____


Casing and Tubing	Used in Drilling	Left in Well	Packers
Size			Kind of Packer
16			
13			
10			Size of
8 1/4	967		
6 5/8			Depth set
5 3/16	1948	1948	
3			Perf. top
2	2058	2058	Perf. bottom
Liners Used			Perf. top
			Perf. bottom

CASING CEMENTED _____ SIZE _____ No. Ft. _____ Date _____

COAL WAS ENCOUNTERED AT _____ FEET _____ INCHES
_____ FEET _____ INCHES _____ FEET _____ INCHES
_____ FEET _____ INCHES _____ FEET _____ INCHES

RESULT AFTER TREATMENT _____
ROCK PRESSURE AFTER TREATMENT _____
Fresh Water _____ Feet _____ Salt Water _____ Feet _____

Formation	Color	Hard or Soft	Top	Bottom	Oil, Gas or Water	Depth	Remarks
Pittsburg Coal (Blossom)			498				
Big Dunkard			695	1062			
Salt Sand			1345	1506			
Big Lime			1941	1998			
Big Injun			1996	2063			
Total Depth				2063			

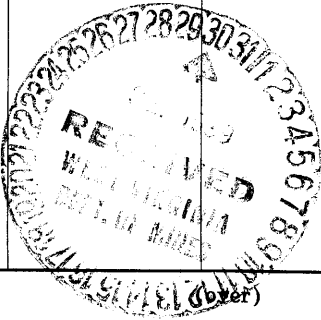

MAR 26 1960