

- New Location...
- Drill Deeper.....
- Abandonment.....

Formerly Hope Natural Gas Co. Well N°4483

Company	LURAY LAND INC.
Address	POINT PLEASANT, WEST VA.
Farm	LEWIS E. DAVIS
Tract	Acres 90 Lease No.
Well (Farm) No.	1 Serial No. 4483
Elevation (Spirit Level)	1325'
Quadrangle	CENTERPOINT
County	DODDRIDGE District McCLELLAN
Engineer	H.P. SUTER
Engineer's Registration No.	1805
File No.	Drawing No.
Date	7 JUNE 1959 Scale 1" = 40 POLES

STATE OF WEST VIRGINIA
DEPARTMENT OF MINES
OIL AND GAS DIVISION
CHARLESTON

WELL LOCATION MAP
FILE NO. DOD-1130-B

+ Denotes location of well on United States Topographic Maps, scale 1 to 62,500, latitude and longitude lines being represented by border lines as shown.

- Denotes one inch spaces on border line of original tracing.



1075

STATE OF WEST VIRGINIA
DEPARTMENT OF MINES
OIL AND GAS DIVISION

Quadrangle Centerprint
Permit No. 130-A

WELL RECORD

Oil or Gas Well _____ (KIND)

Company LuRay Land, Inc.
 Address Charleston, W. Va.
 Farm Lewis E. Davis Acres 90
 Location (waters) _____
 Well No. 4483 (D) (H) Elev. 1325'
 District McClellan County Doddridge
 The surface of tract is owned in fee by _____
 Address _____
 Mineral rights are owned by _____
 Address _____
 Drilling commenced 10/2/1916
 Drilling completed 12/16/1916
 Date Shot 1/15/1943 From Gordon & To 4th Sand
 With 50 qts.
 Open Flow _____ /10ths Water in _____ Inch
 _____ /10ths Merc. in _____ Inch
 Volume _____ Cu. Ft.
 Rock Pressure _____ lbs. _____ hrs.
 Oil _____ bbls., 1st 24 hrs.
 WELL ACIDIZED _____
 WELL FRACTURED _____

Casing and Tubing	Used in Drilling	Left in Well	Packers
Size			Kind of Packer
16			
13			<u>8 x 6 A. 2318'</u>
10	<u>358'</u>	<u>352'</u>	Size of
8 3/4	<u>1430'</u>	<u>1422'</u>	<u>5 x 6 B.H 2928'</u>
6 5/8	<u>2323'</u>	<u>2320'</u>	Depth set
5 3/16	<u>2928'</u>	<u>2928'</u>	
3	<u>3047'</u>	<u>-</u>	Perf. top
2	<u>2465'</u>	<u>-</u>	Perf. bottom
Liners Used			Perf. top
			Perf. bottom

CASING CEMENTED _____ SIZE _____ No. Ft. _____ Date _____


COAL WAS ENCOUNTERED AT 978' FEET _____ INCHES
 _____ FEET _____ INCHES FEET _____ INCHES
 _____ FEET _____ INCHES FEET _____ INCHES

RESULT AFTER TREATMENT _____

ROCK PRESSURE AFTER TREATMENT _____

Fresh Water _____ Feet Salt Water _____ Feet

Formation	Color	Hard or Soft	Top	Bottom	Oil, Gas or Water	Depth	Remarks
Pittsburgh Coal			<u>978'</u>	<u>985'</u>			
Dunkard Sand			<u>1419'</u>	<u>1595'</u>	<u>1437'</u> <u>1504'</u>		
Gas Sand			<u>1655'</u>	<u>1710'</u>			
Salt Sand			<u>1870'</u>	<u>1915'</u>			
Maxon Sand			<u>2070'</u>	<u>2203'</u>			
Little Lime			<u>2208'</u>	<u>2218'</u>			
Big Lime			<u>2236'</u>	<u>2292'</u>			
Injun Sand			<u>2292'</u>	<u>2430'</u>			
Berea Sand			<u>2549'</u>	<u>2578'</u>			
Stray Sand			<u>2893'</u>	<u>2903'</u>	<u>2993'-2996'</u>		
Gordon Sand			<u>2984'</u>	<u>3000'</u>			
4th Sand			<u>3037'</u>	<u>3044'</u>			
2nd - 4th Sand			<u>3063'</u>	<u>3075'</u>			
TOTAL DEPTH				<u>3150'</u>			

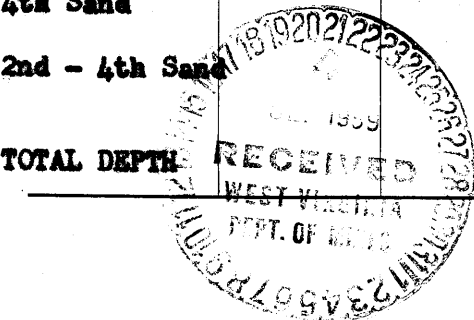

MAR 26 1960

