

Company A. M. SNIDER

Address HUNDRED, W. VA.

Farm I. H. FORD

Tract \_\_\_\_\_ Acres 90 Lease No. 628

Well (Farm) No. \_\_\_\_\_ Serial No. 732

Elevation (Spirit Level) 1003'

Quadrangle Centerpoint

County Doddridge District McClellan

Engineer Henry A. Hain

Engineer's Registration No. 3150

File No. A.M.S.-1-60 Drawing No. \_\_\_\_\_

Date Jan. 20, 1960 Scale 1" = 400'

STATE OF WEST VIRGINIA  
 DEPARTMENT OF MINES  
 OIL AND GAS DIVISION  
 CHARLESTON

**WELL LOCATION MAP**

FILE NO. DoD-1139-A

+ Denotes location of well on United States Topographic Maps, scale 1 to 62,500, latitude and longitude lines being represented by border lines as shown.

- Denotes one inch spaces on border line of original tracing.

70997 ON CNG maps



1084

STATE OF WEST VIRGINIA  
DEPARTMENT OF MINES  
OIL AND GAS DIVISION

Quadrangle Centerpoint

Permit No. 1139-A

WELL RECORD

Oil or Gas Well Gas

Company R. L. Wharton  
Address Hundred, W. Va.  
Farm I.H. Ford Acres 90  
Location (waters) Sycamore Fork  
Well No. 732 Elev. 1003  
District McClellan County Doddridge  
The surface of tract is owned in fee by Woodrow Ashcraft Address Bristol, W. Va.  
Mineral rights are owned by Same Address \_\_\_\_\_  
Drilling commenced May 23, 1905  
Drilling completed July 24, 1905  
Date Shot \_\_\_\_\_ From \_\_\_\_\_ To \_\_\_\_\_  
With \_\_\_\_\_  
Open Flow \_\_\_\_\_ /10ths Water in \_\_\_\_\_ Inch  
\_\_\_\_\_ /10ths Merc. in \_\_\_\_\_ Inch  
Volume \_\_\_\_\_ Cu. Ft.  
Rock Pressure \_\_\_\_\_ lbs. \_\_\_\_\_ hrs.  
Oil \_\_\_\_\_ bbls., 1st 24 hrs.  
WELL ACIDIZED \_\_\_\_\_  
WELL FRACTURED \_\_\_\_\_

Casing and Tubing	Used in Drilling	Left in Well	Packers
Size			Kind of Packer _____
16			<u>W &amp; A</u>
13			Size of <u>5x3</u>
10	<u>320</u>	<u>320</u>	Depth set <u>2609</u>
8 1/4	<u>1440</u>	<u>826</u>	Perf. top _____
6 5/8			Perf. bottom _____
5 3/16	<u>2538</u>	<u>2538</u>	Perf. top _____
3	<u>2744</u>	<u>2744</u>	Perf. bottom _____
2			Perf. top _____
Liners Used			Perf. bottom _____


CASING CEMENTED \_\_\_\_\_ SIZE \_\_\_\_\_ No. Ft. \_\_\_\_\_ Date \_\_\_\_\_  
COAL WAS ENCOUNTERED AT 645 FEET \_\_\_\_\_ INCHES  
\_\_\_\_\_ FEET \_\_\_\_\_ INCHES FEET \_\_\_\_\_ INCHES  
\_\_\_\_\_ FEET \_\_\_\_\_ INCHES FEET \_\_\_\_\_ INCHES

RESULT AFTER TREATMENT \_\_\_\_\_

ROCK PRESSURE AFTER TREATMENT \_\_\_\_\_

Fresh Water \_\_\_\_\_ Feet \_\_\_\_\_ Salt Water \_\_\_\_\_ Feet \_\_\_\_\_

Formation	Color	Hard or Soft	Top	Bottom	Oil, Gas or Water	Depth	Remarks
Pitts. Coal			645	No record			
Dunkard Sand			1045	1225			
Salt Sand			1395	1525			
Maxon Sand			1730	1750			
Injun Sand			1980	2045			
50 ft Sand			2505	2540			
30 ft Sand			2595	2640	Gas	2688	
Stary Sand			2680	2720	"	2710	
Gordon Sand			2725	2735	"		
4th. Sand			2750	2770	"	2760;2770	
Total Depth				2780			

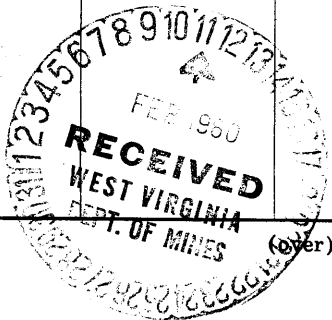

JUN 29 1960