

New Location   
 Drill Deeper   
 Abandonment

Company RICHARD JACKSON INC.  
 Address 614 E. MAIN ST. CLARKSBURG, W. VA.  
 Farm DANIEL S. MORRIS  
 Tract \_\_\_\_\_ Acres 23 Lease No. \_\_\_\_\_  
 Well (Farm) No. 3 Serial No. \_\_\_\_\_  
 Elevation (Spirit Level) 1343'  
 Quadrangle CENTERPOINT  
 County DODDRIDGE District GREENBRIER  
 Engineer [Signature]  
 Engineer's Registration No. 2274  
 File No. \_\_\_\_\_ Drawing No. \_\_\_\_\_  
 Date MAY 13, 1961 Scale 1" = 20 POLES

STATE OF WEST VIRGINIA  
 DEPARTMENT OF MINES  
 OIL AND GAS DIVISION  
 CHARLESTON

**WELL LOCATION MAP**  
 FILE NO. DOD-1155-A

+ Denotes location of well on United States Topographic Maps, scale 1 to 62,500, latitude and longitude lines being represented by border lines as shown.

- Denotes one inch spaces on border line of original tracing.



1098

STATE OF WEST VIRGINIA  
DEPARTMENT OF MINES  
OIL AND GAS DIVISION

Quadrangle Centerpoint

Permit No. 1155-A

WELL RECORD

Oil or Gas Well well  
(KIND)

Company Richard Jackson, Inc.  
Address 614 E. Main St., Clarksburg, W. Va.  
Farm Daniel S. Morris Acres 25  
Location (waters) \_\_\_\_\_  
Well No. 3 Elev. 1843'  
District Greenbrier County Doddridge  
The surface of tract is owned in fee by Daniel S. Morris Address \_\_\_\_\_  
Mineral rights are owned by South Penn Oil Company  
Wolf Summit, W. Va. Address \_\_\_\_\_  
Drilling commenced \_\_\_\_\_  
Drilling completed \_\_\_\_\_  
Date Shot \_\_\_\_\_ From \_\_\_\_\_ To \_\_\_\_\_  
With \_\_\_\_\_  
Open Flow \_\_\_\_\_ /10ths Water in \_\_\_\_\_ Inch  
\_\_\_\_\_ /10ths Merc. in \_\_\_\_\_ Inch  
Volume \_\_\_\_\_ Cu. Ft.  
Rock Pressure \_\_\_\_\_ lbs. \_\_\_\_\_ hrs.  
Oil \_\_\_\_\_ bbls., 1st 24 hrs.  
WELL ACIDIZED \_\_\_\_\_  
WELL FRACTURED \_\_\_\_\_

Casing and Tubing	Used in Drilling	Left in Well	Packers
Size			Kind of Packer
16			
13			
10			Size of
8 1/4		<b>1805'</b>	
6 5/8		<b>1999'</b>	Depth set
5 3/16		<b>2982'</b>	
3			Perf. top
2		<b>3207'</b>	Perf. bottom
Liners Used			Perf. top
			Perf. bottom

CASING CEMENTED \_\_\_\_\_ SIZE \_\_\_\_\_ No. Ft. \_\_\_\_\_ Date \_\_\_\_\_


COAL WAS ENCOUNTERED AT \_\_\_\_\_ FEET \_\_\_\_\_ INCHES  
\_\_\_\_\_ FEET \_\_\_\_\_ INCHES \_\_\_\_\_ FEET \_\_\_\_\_ INCHES  
\_\_\_\_\_ FEET \_\_\_\_\_ INCHES \_\_\_\_\_ FEET \_\_\_\_\_ INCHES

RESULT AFTER TREATMENT \_\_\_\_\_

ROCK PRESSURE AFTER TREATMENT \_\_\_\_\_

Fresh Water \_\_\_\_\_ Feet \_\_\_\_\_ Salt Water \_\_\_\_\_ Feet \_\_\_\_\_

Formation	Color	Hard or Soft	Top	Bottom	Oil, Gas or Water	Depth	Remarks
Pitts. Coal			1085	1090			
Deniard Sand			1603	1672			
Salt Sand			1819	1878			
Maxon Sand			2198	2278			
Big Lime			2368	2438			
Big Injun			2438	2548			
Fifty Foot			2972	2980			
Stray Sand			3143	3158			
Gordon Sand			3185	3195			
1 st. Pay			3190				
Oil Light			3190				
Total Depth				3207			

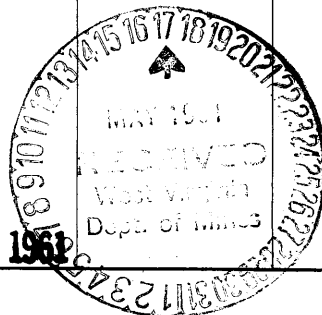

AUG 2 1961

(over)

DANIEL S MORRIS No 3 - RICHARD JACKSON 27500 1155-A