


Latitude 39° 25'

Longitude 80° 30'

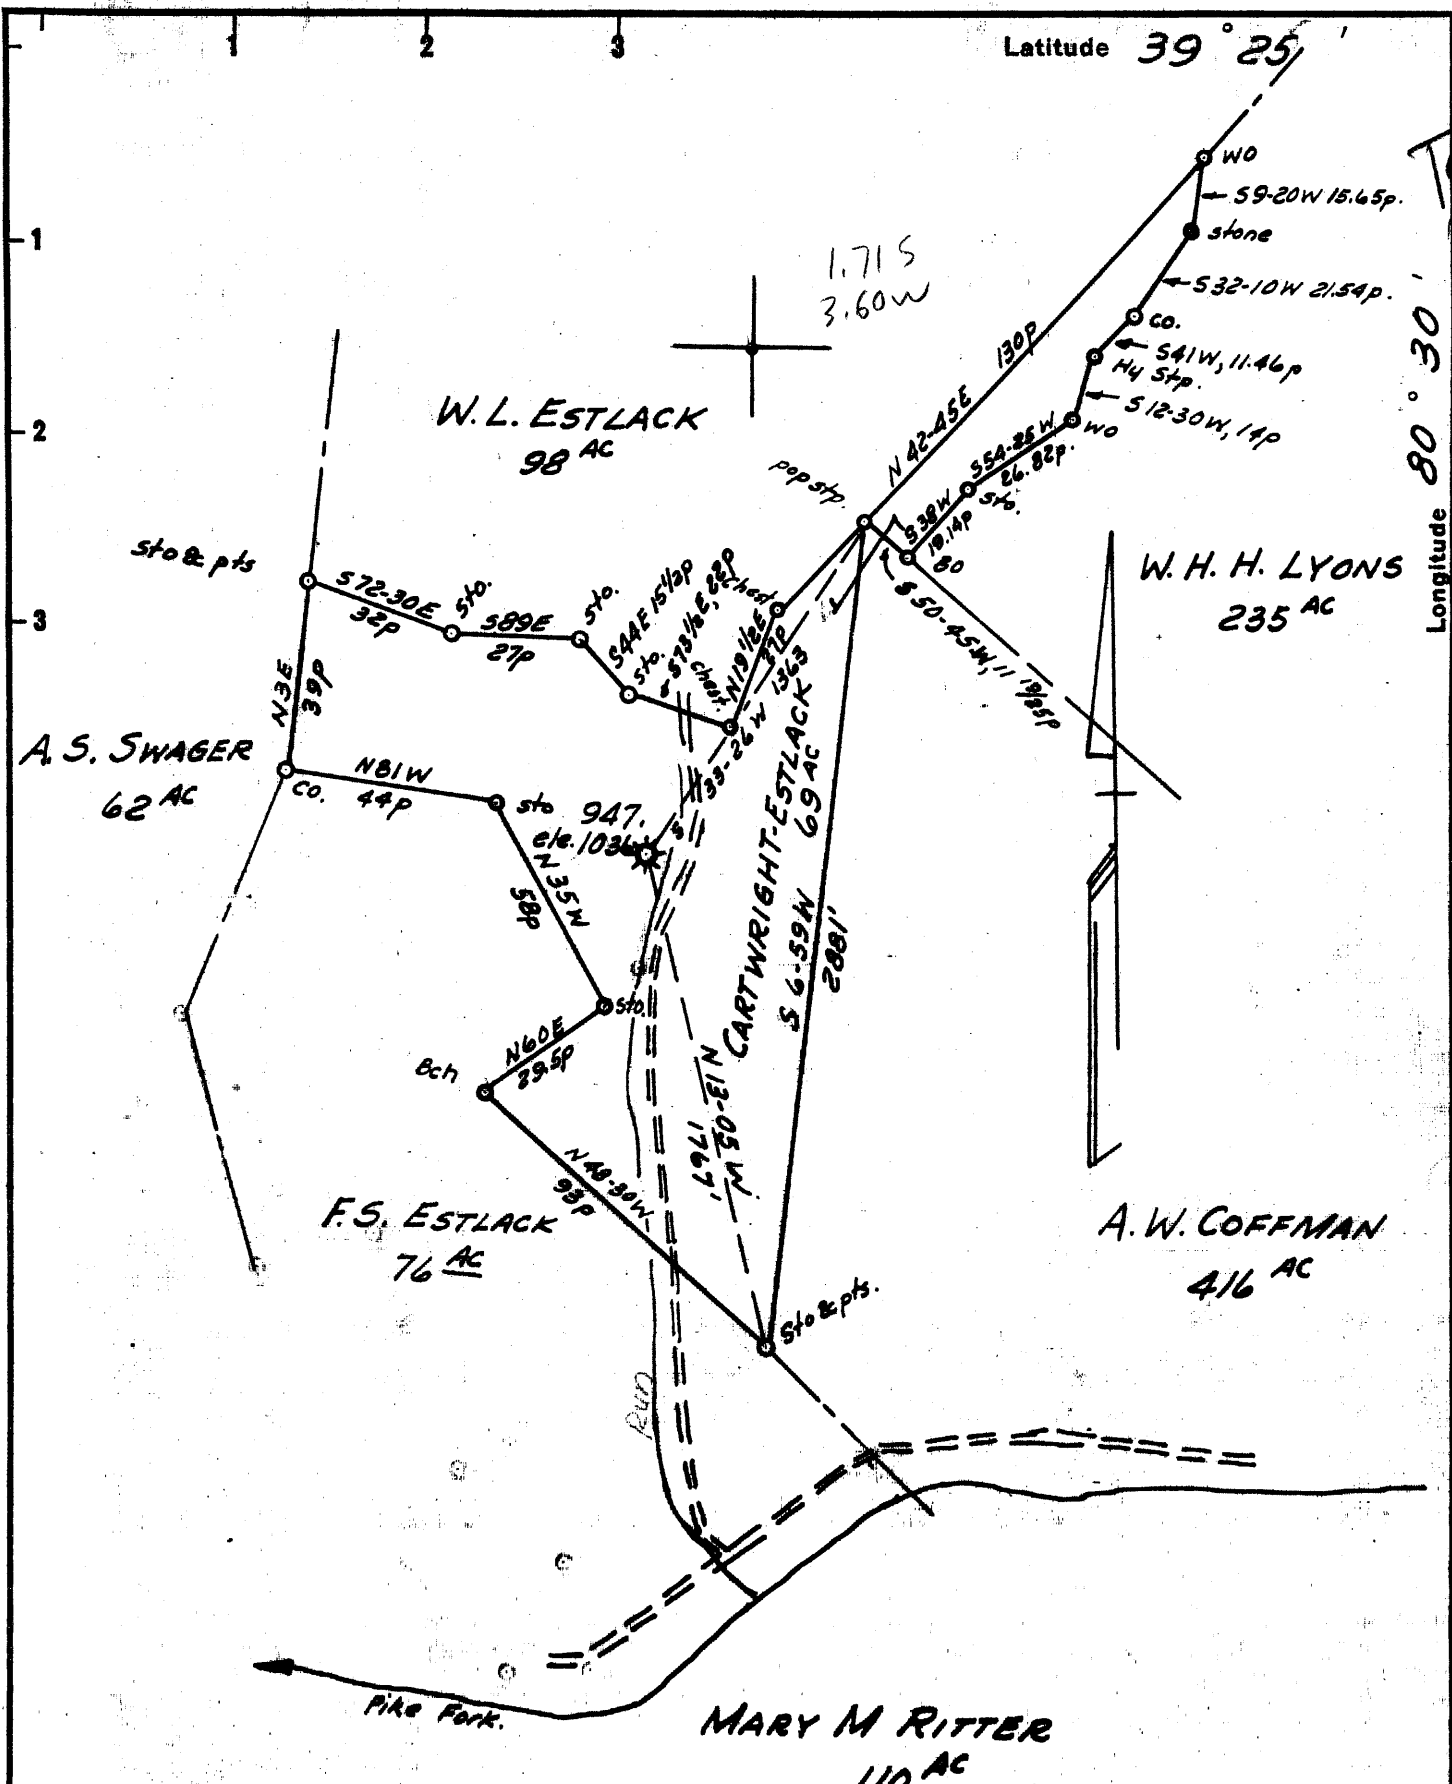

- New Location
- Drill Deeper
- Abandonment

gwn

FB 1136 p 10
M.S. 45 54E3 FB. 545 p 23-26

Company HOPE NATURAL GAS CO
 Address CLARKSBURG, W.VA.
 Farm CARTWRIGHT-ESTLACK
 Tract _____ Acres 69 Lease No. 1277
 Well (Farm) No. _____ Serial No. 947
 Elevation (Spirit Level) 1036'
 Quadrangle CENTERPOINT - EC
 County DODDRIDGE District MCCOLLAN
 Engineer Guy H Bradley
 Engineer's Registration No. 2429
 File No. _____ Drawing No. 1" = 40P
 Date 6-25-64 Scale _____

STATE OF WEST VIRGINIA
 DEPARTMENT OF MINES
 OIL AND GAS DIVISION
 CHARLESTON

WELL LOCATION MAP
 FILE NO. DOD-1183-A

+ Denotes location of well on United States Topographic Maps, scale 1 to 62,500, latitude and longitude lines being represented by border lines as shown.

- Denotes one inch spaces on border line of original tracing.
 70989 on CNG map