


77 11 E

LATITUDE 39° 12' 30"
15' 39° 15'

(15) 80° 30' 30"
LONGITUDE 80° 32' 30"

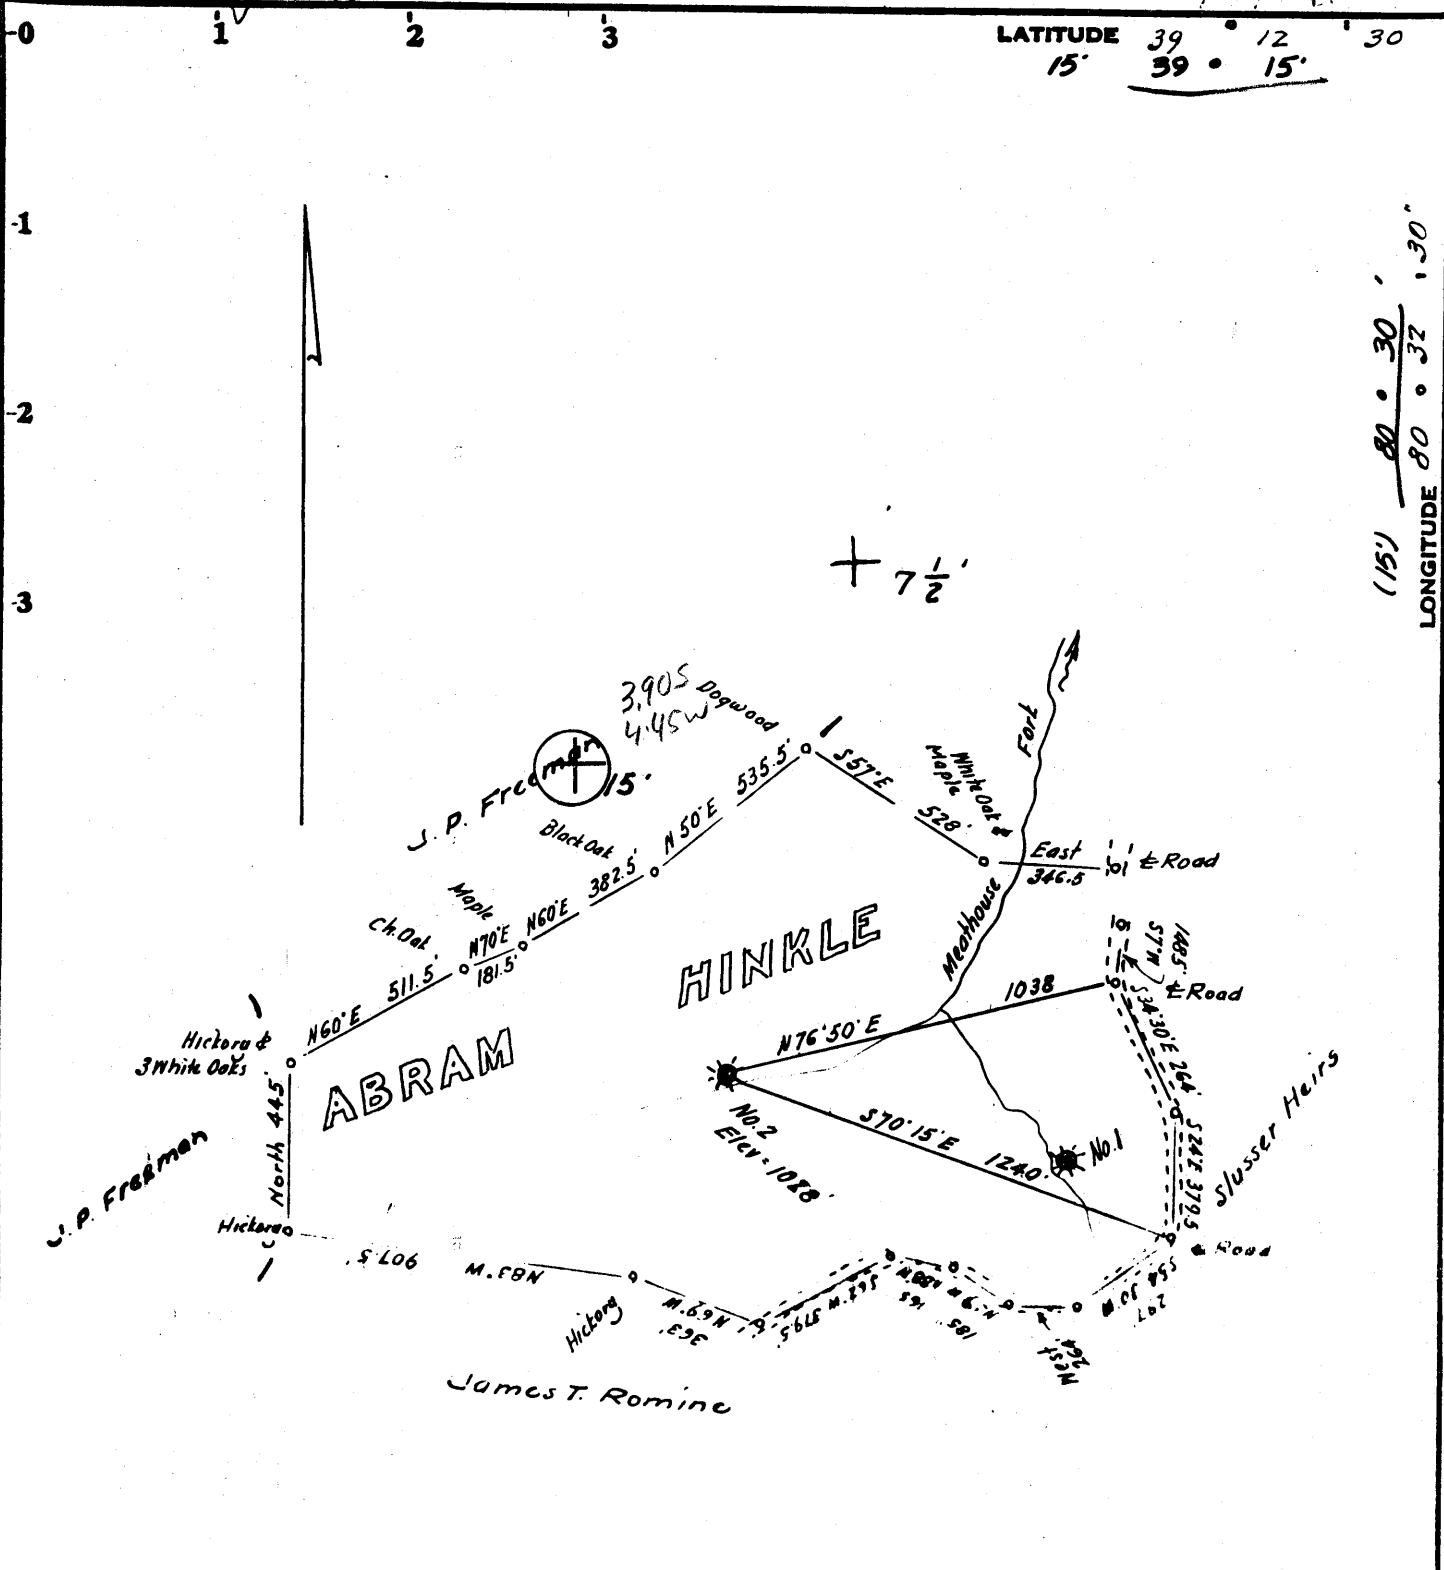

Source of Elevation U.S.G.S. B.M. at Big Isaac = 985

- Fracture.....
- New Location.....
- Drill Deeper.....
- Abandonment.....

I, the undersigned, hereby certify that this map is correct to the best of my knowledge and belief and shows all the information required by paragraph 6 of the rules and regulations of the oil and gas section of the mining laws of West Virginia.

Signed: [Signature]
Squares: N S E W

Map No. _____

Company Hugh Spencer

Address West Union, W. Va.

Farm Abram Hinkle

Tract _____ Acres 62 Lease No. _____

Well (Farm) No. Two Serial No. _____

Elevation (Spirit Level) 1028 NE 1028

Quadrangle Big Isaac 7 1/2', Vadis 15'

County Doddridge District Greenbrier

Engineer [Signature]

Engineer's Registration No. 1227 LLS No 200

File No. _____ Drawing No. _____

Date Dec. 13, 1976 Scale 1" = 500'

STATE OF WEST VIRGINIA
DEPARTMENT OF MINES
OIL AND GAS DIVISION
CHARLESTON

WELL LOCATION MAP

FILE NO. DODD-1279-A

+ Denotes location of well on United States Topographic Maps, scale 1 to ^{62,500}/_{29,000} latitude and longitude lines being represented by border lines as shown.

— Denotes one inch spaces on border line of original tracing. **47-017**